



MEMORANDUM

TO: Bob Klein, Chair, and Members of the Alcoholic Beverage Control Board DATE: April 29, 2019

FROM: Erika McConnell, Director RE: 5757 AK Alchemist

Requested Action: New license application

Statutory Authority: AS 04.06.090(b): “The board shall review all applications for licenses made under this title and may order the director to issue, renew, revoke, transfer, or suspend licenses and permits authorized under this title.”

AS 04.11.480(a): “A local governing body may protest the issuance, renewal, relocation, or transfer to another person of a license by sending the board and the applicant a protest and the reasons for the protest within 60 days of receipt from the board of notice of filing of the application... The board shall consider a protest and testimony received at a hearing conducted under AS 04.11.510(b)(2) or (4) when it considers the application... If an application or continued operation is protested, the board shall deny the application or continued operation unless the board finds that the protest is arbitrary, capricious, and unreasonable.”

AS 04.11.510(b)(2): “The board may review an application for the issuance, renewal, transfer of location, or transfer to another person of a license without affording the applicant notice or hearing, except...(2) the board may, on its own initiative or in response to an objection or protest, hold a hearing to ascertain the reaction of the public or a local governing body to an application if a hearing is not required under this subsection;”

Staff Rec.: Hold a public hearing; deny the application with a 180-day abeyance

Background: The Municipality of Anchorage protests this new restaurant or eating place license pending payment of all taxes, fees, or fines; certification from the Planning Department that all conditions of the conditional use permit are met; and certifications from the Department of Health and Human Services, the Building Safety Official and the Anchorage Fire Department.

The licensee should be notified that under 3 AAC 304.145(h), this abeyance period may not be extended or renewed.

This applicant used to hold restaurant or eating place license 5367 for this establishment. The Municipality protested the renewal of the license in 2018, which was upheld by the board with an abeyance period. The licensee was unable to satisfy all requirements and have the protest lifted within the abeyance period, so that license was expired.

Attachment: Municipality of Anchorage protest
New license application



Municipality of Anchorage

P.O. Box 196650 • Anchorage, Alaska 99519-6650 • Telephone: (907) 343-4316 • Fax: (907) 249-7533 <http://www.muni.org/assembly/license>

April 10, 2019

Office of the Municipal Clerk Licensing

Ms. Mikal Milton
Alaska Alcohol and Marijuana Control Office
550 W 7th Ave. Ste. 1600
Anchorage, Alaska 99501

RE: Anchorage Assembly Action on Liquor Licenses

Dear Ms. Milton:

The Anchorage Municipal Assembly at its regular meeting on **April 9, 2019** took the following final actions:

WAIVE OF PROTEST

Renewal Liquor License – AM 229-2019

- **Beverage Dispensary**
Playhouse, LL#4356
- **Restaurant/Eating Place**
Gumbo House, LL#4275

Renewal Liquor License – AM 230-2019

- **Beverage Dispensary**
Time Out Lounge, LL#1140
Spenard Roadhouse, LL#4825
Long Branch Saloon, LL#670
Jalapenos Mexican Restaurant, LL#3518
Gallo's Mexican Restaurant 2, LL#3572
- **Beverage Dispensary-Tourism**
Sushi on the Fly, LL#5397
The Lakefront Anchorage-A Millennium Hotel, LL#2486
Courtyard by Marriott, LL#3694
- **Restaurant/Eating Place**
Uncle Joe's Pizzeria, LL#4293
Peggy's Restaurant, LL#1821
Shanghai Tea Garden, LL#1805
Bombay Deluxe Restaurant, LL#415
Hula Hands Restaurant, LL#4933
Wingstop, LL#5523
Ramen House by Saijo, LL#5567
Residence Inn by Marriott, LL#3934
- **Package Store**
Liquor Locker, LL#757
Sam's Club 6602, LL#2386
Sam's Club 6601, LL#3303
Wal-Mart Supercenter 2071, LL#4836
- **Club**
V.F.W. Post 9981, LL#2706
American Legion Post 28, LL#59



- **Wholesale-General**
K&L Beverage Company, LL#3964
- **Wholesale Malt Beverage & Wine**
Turnagain Vines, LL#4414
- **Winery**
Alaska Denali Winery, LL#5090

PROTEST

Renewal Liquor License

- **Beverage Dispensary-Tourism**
PubHouse LL#4283 – AR 2019-110
Pending payment in full of taxes owed to the Municipality in the amount of \$6,023.22.
-Per 3 AAC 304.145(d) the applicant was given the opportunity to defend their application by public hearing at the April 9, 2019 Assembly Meeting.

New Liquor License

- **Restaurant/Eating Place**
AK Alchemist LL#5757 – AR 2019-111
Pending payment of all taxes, fees or fines found due to the Municipality, pending certification from the Planning Department that all conditions of the Assembly approved conditional land use permit have been met, and pending certifications from the Department of Health & Human Services, the Building Safety Official and the Anchorage Fire Department.
-Per 3 AAC 304.145(d) the applicant was given the opportunity to defend their application by public hearing at the April 9, 2019 Assembly Meeting.
The applicant requested his application be moved to the next possible Assembly meeting so that his application could go before the ABC Board at the April meeting. The Clerk's Office notified the applicant that due to the time the application was received from AMCO and the date the applicant made the request, no inspections or reviews had been conducted and so the application would be protested pending all reviews and certifications required. He agreed.

Any prior conditions placed on any license are to continue until specifically removed or amended. If you require additional information or if I can be of any assistance please call me.

Cordially,



Mandy Honest
Business License Official

CC: Bistro IT, LLC – Via Email
AK Alchemist, LLC – Via Email





Alaska Alcoholic Beverage Control Board
Form AB-00: New License Application

What is this form?

This new license application form is required for all individuals or entities seeking to apply for a new liquor license. Applicants should review Title 04 of Alaska Statutes and Chapter 304 of the Alaska Administrative Code. All fields of this form must be completed, per AS 04.11.260 and 3 AAC 304.105.

This form must be completed and submitted to AMCO's main office, along with all other required forms and documents, before any license application will be considered complete.

Section 1 – Establishment and Contact Information

Enter information for the business seeking to be licensed.

Licensee:	AK Alchemist, LLC			AS 04.11.100	
License Type:	Restaurant Eating place	Statutory Reference:	46-3032459		
Doing Business As:	AK Alchemist				
Premises Address:	103 E 4th Ave				
City:	Anchorage	State:	Alaska	ZIP:	99501
Local Governing Body:	Municipality of Anchorage				
Community Council:	Downtown Community Council				

Mailing Address:	3420 North Shore Dr				
City:	Anchorage	State:	Alaska	ZIP:	99502

Designated Licensee:	Anchorage Adam Blomfield				
Contact Phone:	907 632-6566	Business Phone:	907 632-6566		
Contact Email:	Adam@blomfieldcompany.com				

Seasonal License? Yes No If "Yes", write your six-month operating period: _____

OFFICE USE ONLY					
Complete Date:	3/10/19	License Years:	19/20	License #:	5757
Board Meeting Date:	4/29/19	Transaction #:	1013138		
Issue Date:					





Alaska Alcoholic Beverage Control Board

Form AB-00: New License Application

Section 2 – Premises Information

Premises to be licensed is:

- an existing facility a new building a proposed building

The next two questions must be completed by beverage dispensary (including tourism) and package store applicants only:

What is the distance of the shortest pedestrian route from the public entrance of the building of your proposed premises to the outer boundaries of the nearest school grounds? Include the unit of measurement in your answer.

.5 mile

What is the distance of the shortest pedestrian route from the public entrance of the building of your proposed premises to the public entrance of the nearest church building? Include the unit of measurement in your answer.

.5 Mile

Section 3 – Sole Proprietor Ownership Information

This section must be completed by any sole proprietor who is applying for a license. Entities should skip to Section 4.

If more space is needed, please attach a separate sheet with the required information.

The following information must be completed for each licensee and each affiliate (spouse).

This individual is an: applicant affiliate

Name:					
Address:					
City:		State:		ZIP:	

This individual is an: applicant affiliate

Name:					
Address:					
City:		State:		ZIP:	



Alaska Alcoholic Beverage Control Board
Form AB-00: New License Application

Section 4 – Entity Ownership Information

This section must be completed by any entity, including a corporation, limited liability company (LLC), partnership, or limited partnership, that is applying for a license. Sole proprietors should skip to Section 5.
 If more space is needed, please attach a separate sheet with the required information.

- If the applicant is a corporation, the following information must be completed for each *stockholder who owns 10% or more* of the stock in the corporation, and for each *president, vice-president, secretary, and managing officer*.
- If the applicant is a limited liability organization, the following information must be completed for each *member with an ownership interest of 10% or more*, and for each *manager*.
- If the applicant is a partnership, including a limited partnership, the following information must be completed for each *partner with an interest of 10% or more*, and for each *general partner*.


Entity Official:	Adam Blomfield				
Title(s):	MEMBER	MANAGER	Phone:	907 632-6566	% Owned: 100
Address:	3420 North Shore Dr				
City:	Anchorage	State:	Alaska	ZIP:	99502

Entity Official:					
Title(s):		Phone:		% Owned:	
Address:					
City:		State:		ZIP:	

Entity Official:					
Title(s):		Phone:		% Owned:	
Address:					
City:		State:		ZIP:	

Entity Official:					
Title(s):		Phone:		% Owned:	
Address:					
City:		State:		ZIP:	



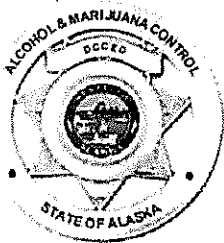

Alaska Alcoholic Beverage Control Board

Form AB-00: New License Application

This subsection must be completed by any applicant that is a corporation or LLC. Corporations and LLCs are required to be in good standing with the Alaska Division of Corporations (DOC) and have a registered agent who is an individual resident of the state of Alaska.

DOC Entity #:	10012850	AK Formed Date:	5/10/13	Home State:	Alaska
Registered Agent:	Adam Blomfield		Agent's Phone:	907 632-6566	
Agent's Mailing Address:	3420 North Shore Drive				
City:	Anchorage	State:	Alaska	ZIP:	99502

Residency of Agent: Yes No

Is your corporation or LLC's registered agent an individual resident of the state of Alaska?

Section 5 – Other Licenses

Ownership and financial interest in other alcoholic beverage businesses: Yes No

Does any representative or owner named in this application have any direct or indirect financial interest in any other alcoholic beverage business that does business in or is licensed in Alaska?

If "Yes", disclose which individual(s) has the financial interest, what the type of business is, and if licensed in Alaska, which license number(s) and license type(s):

Section 6 – Authorization

Communication with AMCO staff: Yes No

Does any person other than a licensee named in this application have authority to discuss this license with AMCO staff?

If "Yes", disclose the name of the individual and the reason for this authorization:

Dan Coffey



Alaska Alcoholic Beverage Control Board Form AB-00: New License Application

Section 7 – Certifications

Read each line below, and then sign your initials in the box to the right of each statement:

Initials

I certify that all proposed licensees (as defined in AS 04.11.260) and affiliates have been listed on this application.

AB

I certify that all proposed licensees have been listed with the Division of Corporations.

AB

I certify that I understand that providing a false statement on this form or any other form provided by AMCO is grounds for rejection or denial of this application or revocation of any license issued.

AB

I certify that all licensees, agents, and employees who sell or serve alcoholic beverages or check the identification of a patron will complete an approved alcohol server education course, if required by AS 04.21.025, and, while selling or serving alcoholic beverages, will carry or have available to show a current course card or a photocopy of the card certifying completion of approved alcohol server education course, if required by 3 AAC 304.465.

AB

I agree to provide all information required by the Alcoholic Beverage Control Board in support of this application.

AB

As an applicant for a liquor license, I declare under penalty of perjury that I have read and am familiar with AS 04 and 3 AAC 304, and that this application, including all accompanying schedules and statements, is true, correct, and complete.

AL

Signature of licensee

[Signature]

Signature of Notary Public

Adam Blamfield

Printed name of licensee

Notary Public in and for the State of Alaska

My commission expires: 6/06/2022



Subscribed and sworn to before me this 24 day of December, 2018.



Alaska Alcoholic Beverage Control Board

Form AB-02: Premises Diagram

What is this form?

A detailed diagram of the proposed licensed premises is required for all liquor license applications, per AS 04.11.260 and 3 AAC 304.185. Your diagram must include dimensions and must show all entrances and boundaries of the premises, walls, bars, fixtures, and areas of storage, service, consumption, and manufacturing. If your proposed premises is located within a building or building complex that contains multiple businesses and/or tenants, please provide an additional page that clearly shows the location of your proposed premises within the building or building complex, along with the addresses and/or suite numbers of the other businesses and/or tenants within the building or building complex.

The second page of this form is not required. Blueprints, CAD drawings, or other clearly drawn and marked diagrams may be submitted in lieu of the second page of this form. The first page must still be completed, attached to, and submitted with any supplemental diagrams. An AMCO employee may require you to complete the second page of this form if additional documentation for your premises diagram is needed.

This form must be completed and submitted to AMCO's main office before any license application will be considered complete.

Yes No


I have attached blueprints, CAD drawings, or other supporting documents in addition to, or in lieu of, the second page of this form.

Section 1 – Establishment Information

Enter information for the business seeking to be licensed, as identified on the license application.

Licensee:	AK Alchemist, LLC	License Number:	5757		
License Type:	Restruant Eating Place				
Doing Business As:	AK Alchemist				
Premises Address:	103 E 4th Ave				
City:	Anchorage	State:	Alaska	ZIP:	99501



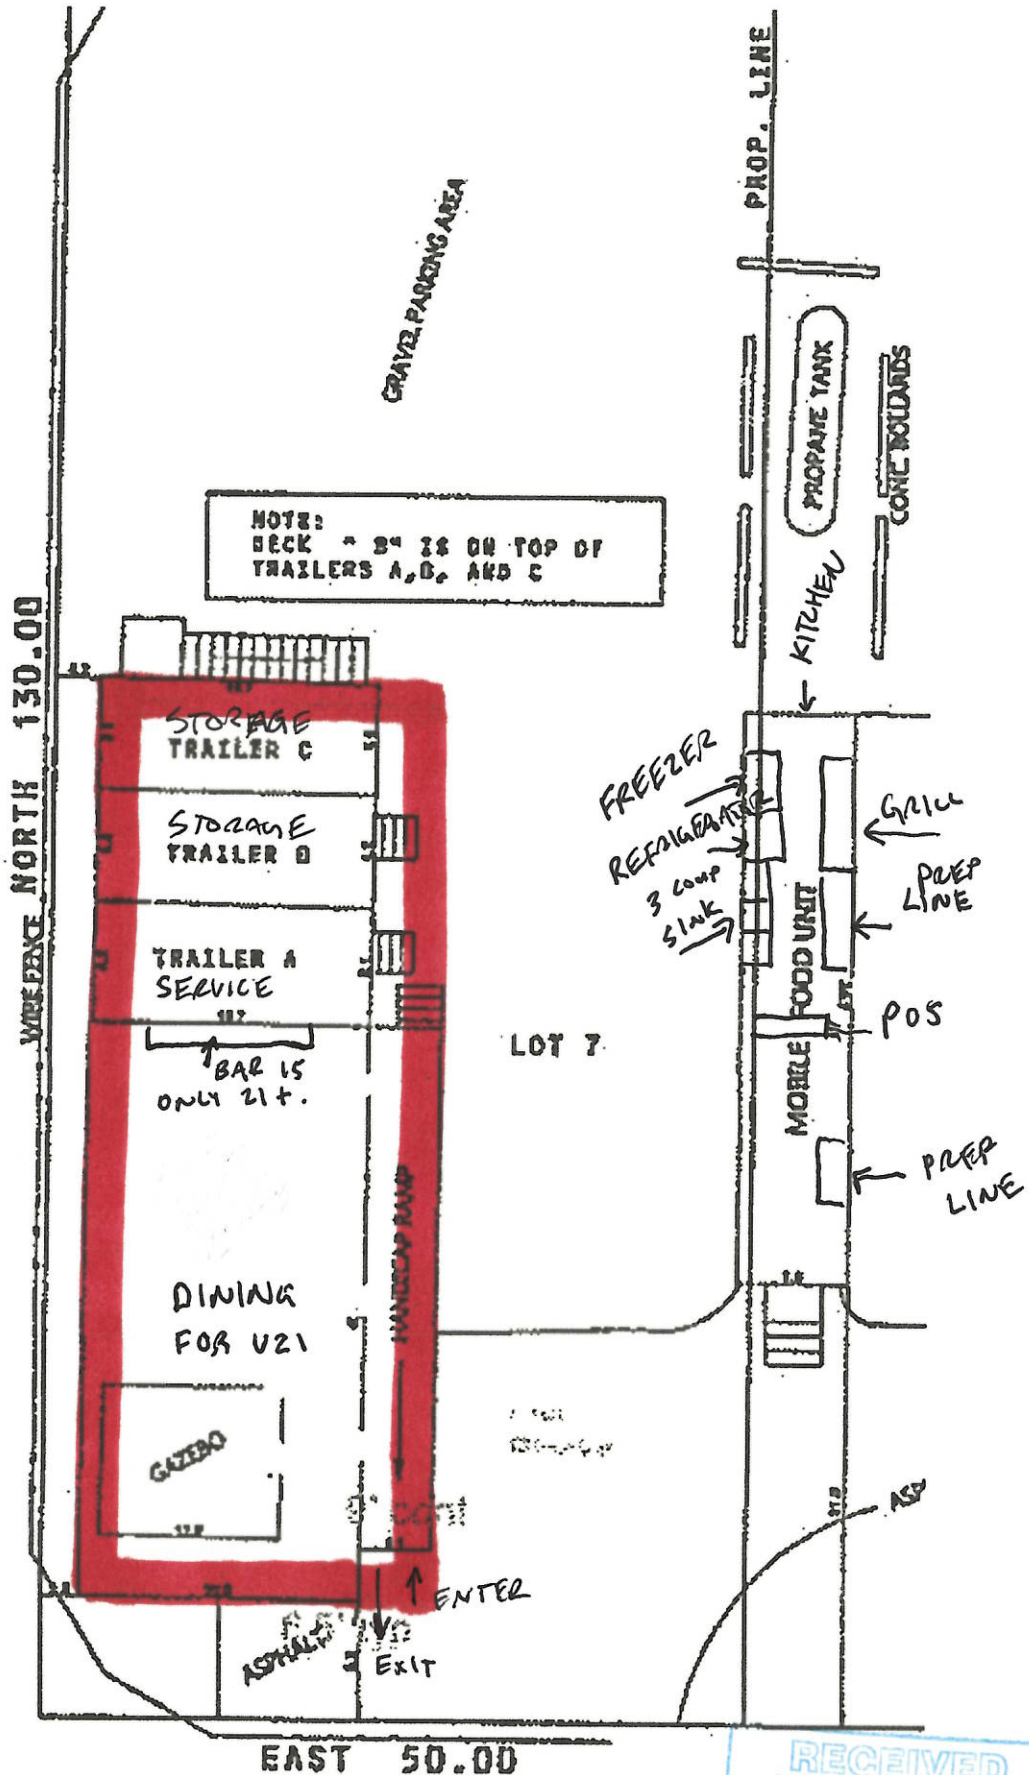

RECEIVED
 FEB 25 2019
 ALCOHOL MARIJUANA CONTROL OFFICE
 STATE OF ALASKA

Plan 1

Ad
adam@blomfield

Statistics

1479 sq ft
1 Floor
0 Office
0 Conf. room


TOTAL LICENSED AREA = 1,500
sqft

CONSUMPTION = 800 sqft

SERVING = 160 sqft


STORAGE = 320 sqft

ANCILLARY = 320 sqft

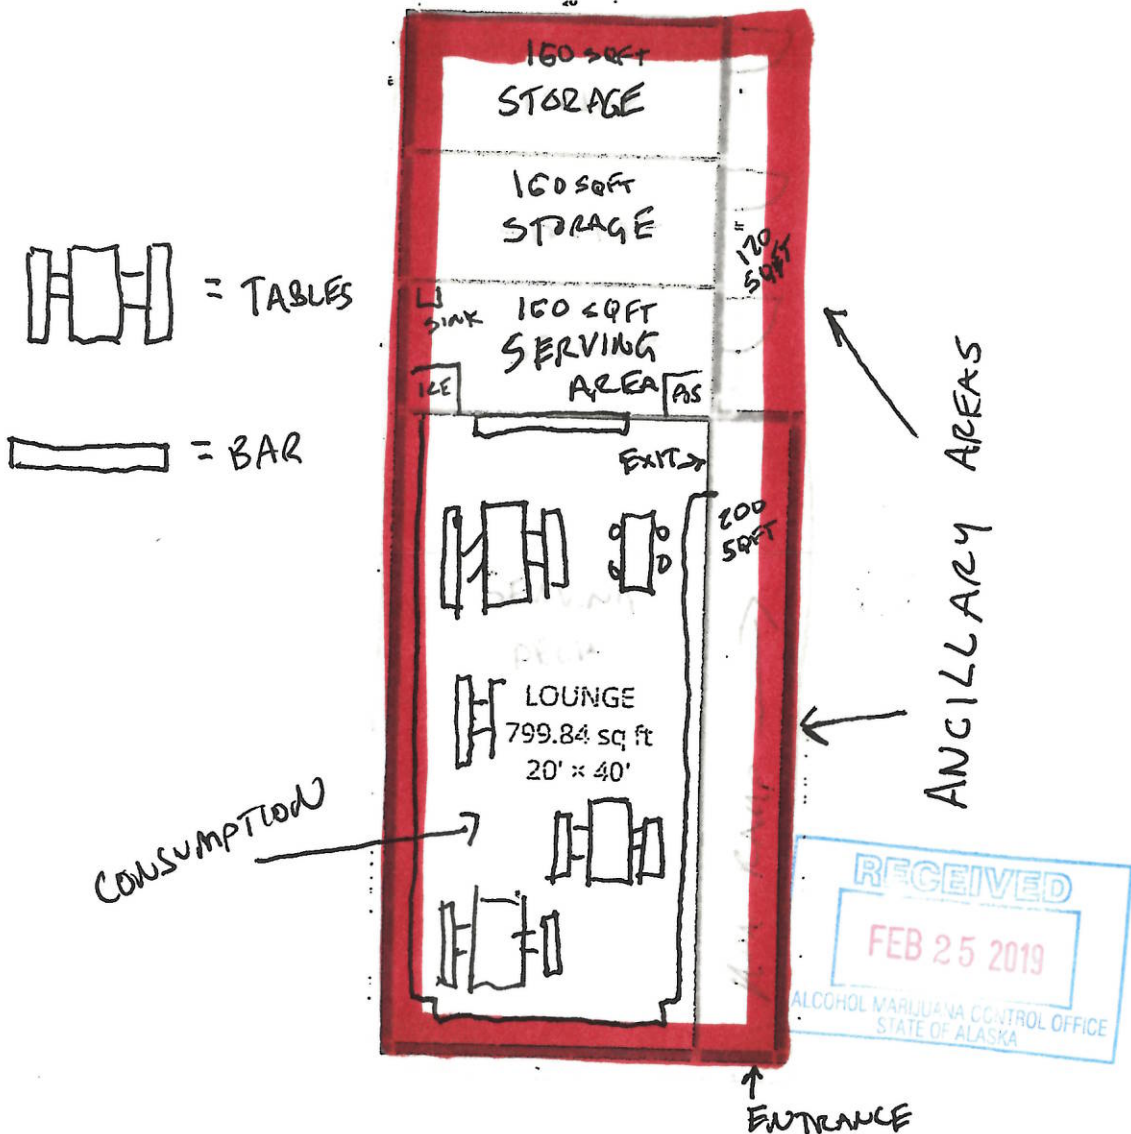

THIS FLOORPLAN IS PROVIDED WITHOUT WARRANTY OF ANY KIND. SENSOPIA DISCLAIMS ANY WARRANTY INCLUDING WITHOUT LIMITATION SATISFACTORY QUALITY OR ACCURACY OF DIMENSIONS

KB-112

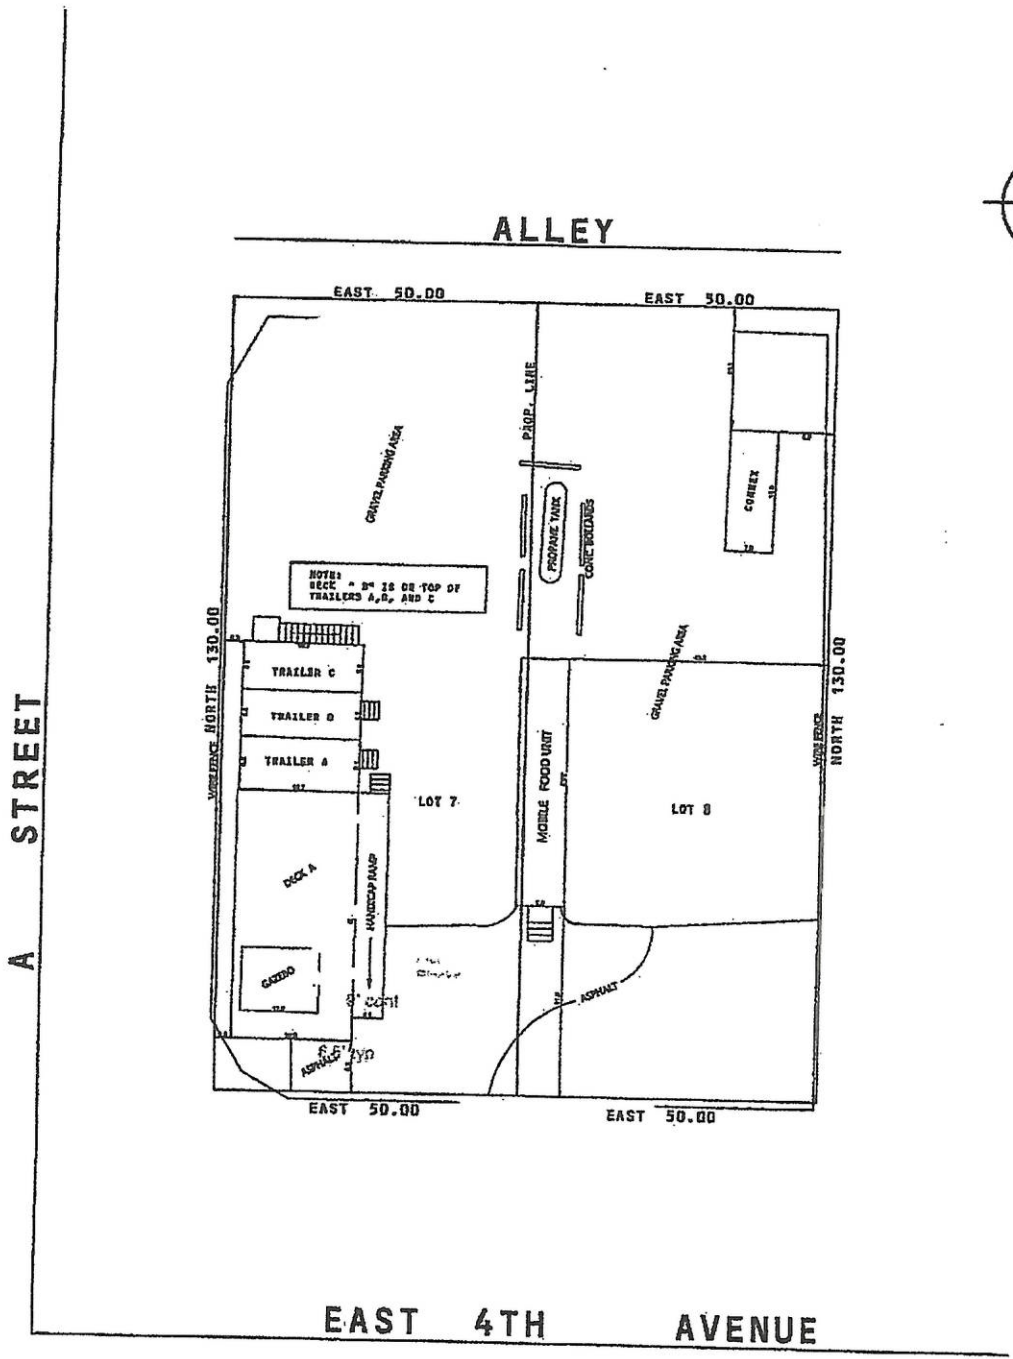

AS-BUILT SURVEY 1" = 20'

NO CORNERS SET THIS DATE

I HEREBY CERTIFY THAT I HAVE PERFORMED A SURVEY OF THE FOLLOWING DESCRIBED PROPERTY

LOTS 7, 8, BLOCK 117, ANCHORAGE ORIGINAL TOWNSHIP

ANCHORAGE RECORDING DISTRICT, ALASKA, AND THE VISIBLE IMPROVEMENTS SITUATED THEREON ARE BY THE PROPERTY LINES AND NO VISIBLE ENCROACHMENTS EXIST OTHER THAN NOTED.

DATED AT ANCHORAGE, ALASKA THIS 16TH DAY

ADDT:

THE INFORMATION HEREON IS FOR THE USE OF LENDING INSTITUTIONS SPECIFICALLY TO SHOW ANY CONFLICTS BETWEEN EXISTING STRUCTURES AND PLATTED LOT LINES AND/OR BASEMENTS; AND IS NOT TO BE USED FOR POSITIONING ADDITIONAL STRUCTURES, IMPROVEMENTS, OR FENCE LINES; BASEMENTS OF RECORD, OTHER THAN THOSE APPEARING ON THE RECORD PLAT, ARE NOT SHOWN

AK Alchemist, LLC

February 25, 2019

3420 North Shore Dr
Anchorage, Alaska 99502

AMCO
550 West Seventh Ave, Suite 1600
Anchorage, Alaska 99501

RE: Security Plan

Dear Carrie Craig:

The following security plan will be implemented by AK Alchemist at the address of 103 E 4th Ave, Anchorage, Alaska 99501.

- 1) All State, Federal, and Local Laws will be followed.
- 2) The consumption areas are sectioned off with either a glass wall, steel wall, or decorative railing.
- 3) All Serving Employees will be TAP certified.
- 4) 100% ID check is implemented when we host an event.
- 5) Security cameras are installed
- 6) We have a trained staff that knows how to assess and prevent patron intoxication
- 7) Persons under the age of 21 are not allow to consume alcohol
- 8) Any persons under 21 are not allowed to sit at the "bar area" on the north bar.
- 9) Proper signage will be posted in accordance with the Alaska Statutes.

This security plan will be posted for all employees and the public.

Best Regards,



Adam Blomfield
AK Alchemist, Owner
907 632-6566
Adam@blomfieldcompany.com

AMCO
FEB 25 2019



Alaska Alcoholic Beverage Control Board

Form AB-03: Restaurant Designation Permit Application

What is this form?

A restaurant designation permit application is required for a licensee desiring designation under 3 AAC 304.715 – 3 AAC 304.795 as a bona fide restaurant, hotel, or eating place for purposes of AS 04.16.010(c) or AS 04.16.049. Designation will be granted only to a holder of a beverage dispensary, club, recreational site, golf course, or restaurant or eating place license, and only if the requirements of 3 AAC 304.305, 3 AAC 304.725, and 3 AAC 304.745, as applicable, are met. A detailed floor plan of the proposed designated and undesignated areas of the licensed business and a menu or expected menu listing the meals to be offered to patrons must accompany this form. Applicants should review AS 04.16.049 – AS 04.16.052 and 3 AAC 304.715 – 3 AAC 304.795. All fields of this form must be completed. The required \$50 permit fee may be made by credit card, check, or money order.

Section 1 – Establishment Information

Enter information for licensed establishment.

Licensee:	AK Alchemist AK Alchemist, LLC		
License Type:	Restaurant Eating Place	License Number:	
Doing Business As:	AK Alchemist LLC AK Alchemist		
Premises Address:	103 E 4th Ave		
City:	Anchorage	State:	AK
		ZIP:	99501
Contact Name:	Adam Blomfield	Contact Phone:	907 632-6566

Section 2 – Type of Designation Requested

This application is for the request of designation as a bona fide restaurant, hotel, or eating place for purposes of AS 04.16.010(c) or AS 04.16.049, and for the request of the following designation(s) (check all that apply):

- Dining after standard closing hours: AS 04.16.010(c)
- Dining by persons 16 – 20 years of age: AS 04.16.049(a)(2)
- Dining by persons under the age of 16 years, accompanied by a person over the age of 21: AS 04.16.049(a)(3)
- Employment for persons 16 or 17 years of age: AS 04.16.049(c)

NOTE: Under AS 04.16.049(d), this permit is not required to employ a person 18 - 20 years of age.

OFFICE USE ONLY			
Issue Date:		Transaction #:	1013138
		BRE:	CDC





Alaska Alcoholic Beverage Control Board

Form AB-03: Restaurant Designation Permit Application

Section 3 – Additional Information

Enter all hours that your establishment intends to be open. Include variances in weekend/weekday hours, and indicate am/pm:

5:00am-midnight Daily

Are any forms of entertainment offered or available within the licensed business or on the proposed designated portions of the premises?

Yes No

If "Yes", describe the entertainment offered or available:

Bands, DJ's, special events

Food and beverage service offered or anticipated is:

table service buffet service counter service other

If "other", describe the manner of food and beverage service offered or anticipated:

[Empty box for describing other food and beverage service]

Is an owner, manager, or assistant manager 21 years of age or older always present on the premises during business hours?

Yes No

Blueprints, CAD drawings, or other clearly drawn and marked diagrams may be submitted in lieu of the third page of this form.

I have attached blueprints, CAD drawings, or other supporting documents in addition to, or in lieu of, the third page of this form that meet the requirements of this form.

Yes No

Plan 1

Ad
adam@blomfield

Statistics

1479 sq ft
1 Floor
0 Office
0 Conf. room


TOTAL LICENSED AREA = 1,500
sqft

CONSUMPTION = 800 sqft

SERVING = 150 sqft

STORAGE = 320 sqft

ANCILLARY = 320 sqft

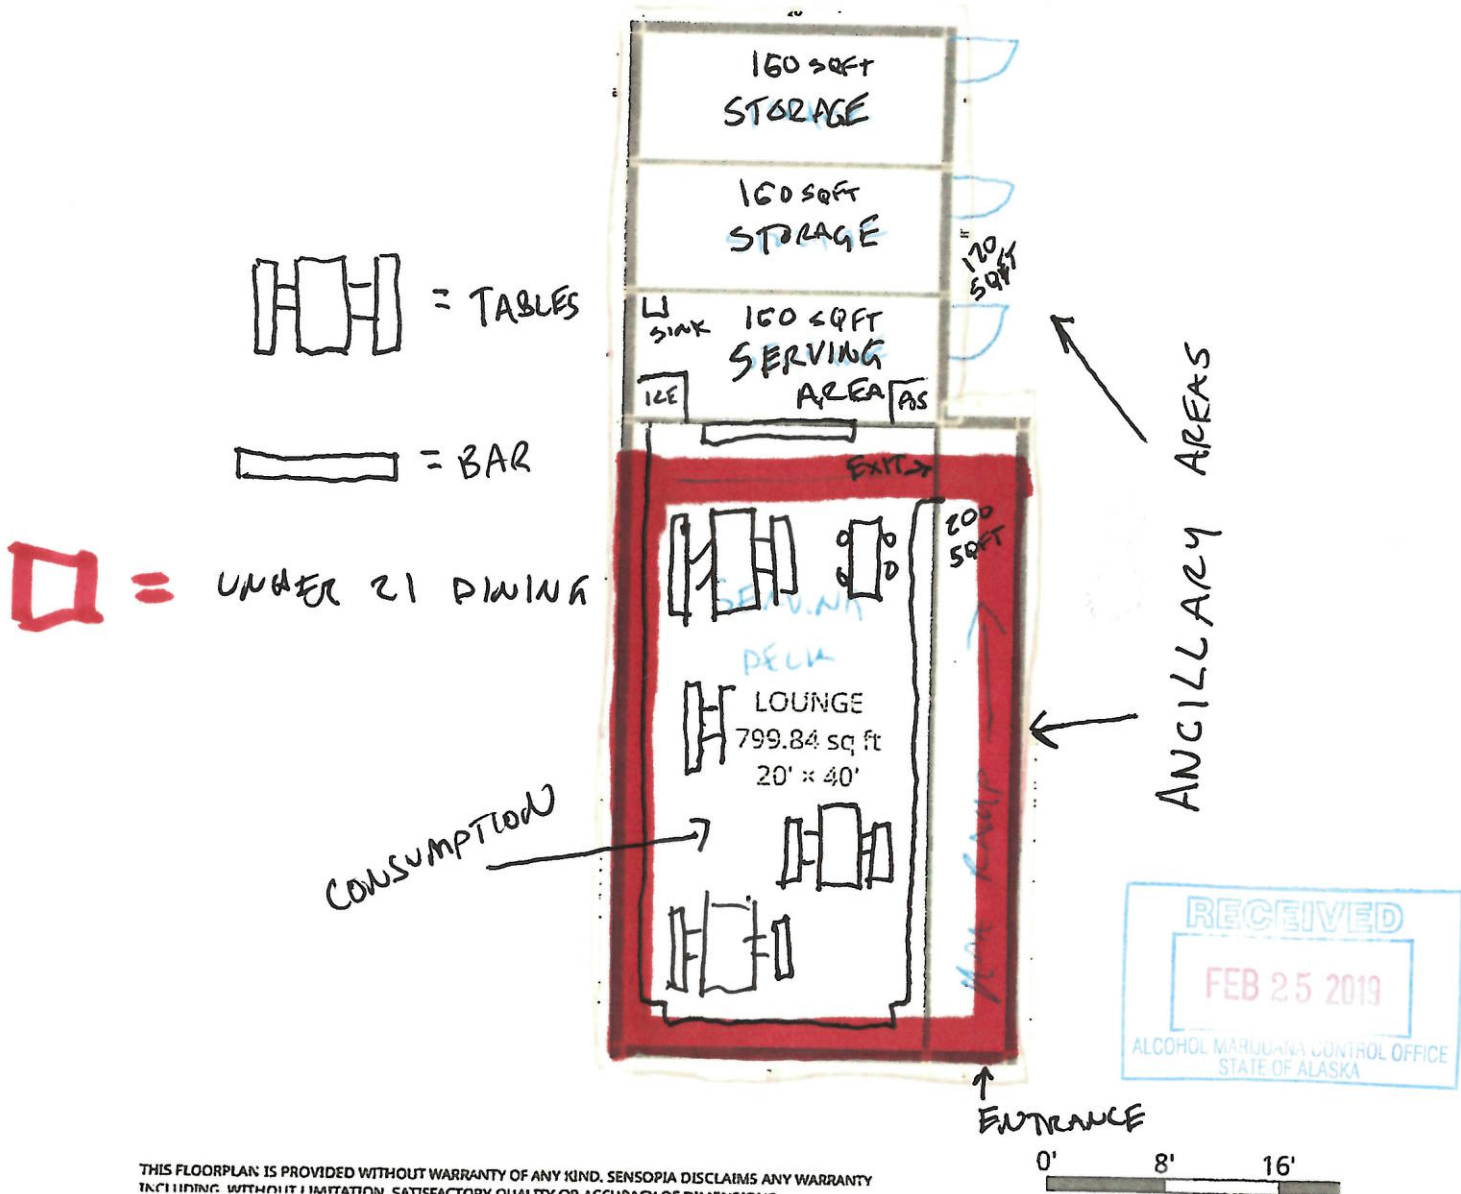



[Symbol] = TABLES

[Symbol] = BAR


THIS FLOORPLAN IS PROVIDED WITHOUT WARRANTY OF ANY KIND. SENSOPIA DISCLAIMS ANY WARRANTY INCLUDING WITHOUT LIMITATION SATISFACTORY QUALITY OR ACCURACY OF DIMENSIONS

AB-03

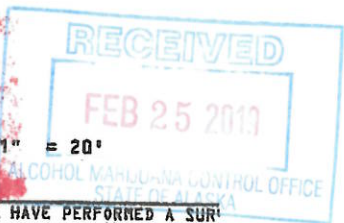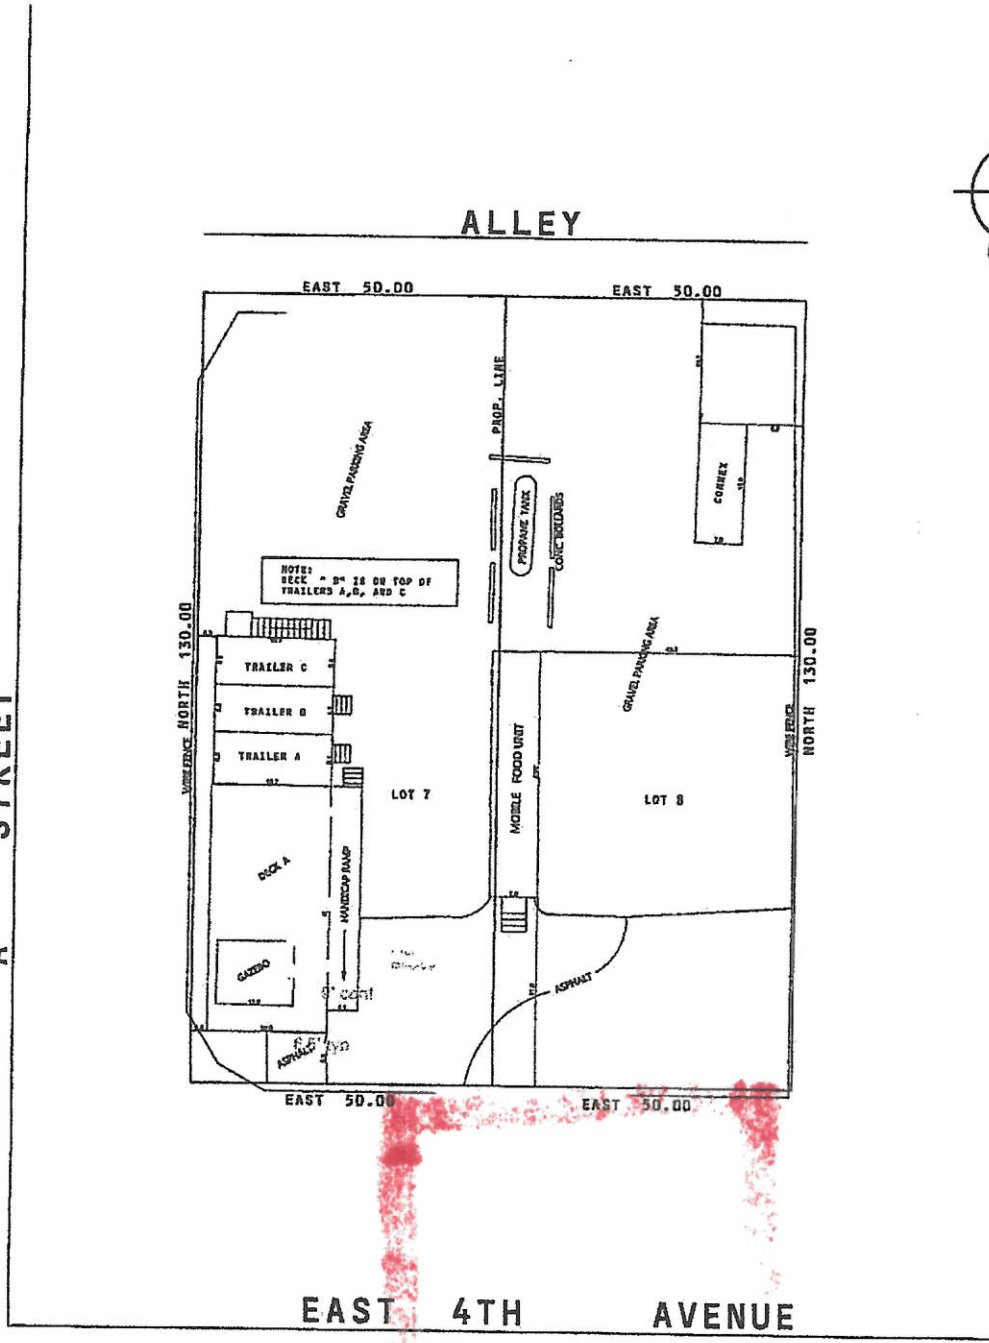

AS-BUILT SURVEY 1" = 20'

NO CORNERS SET THIS DATE

I HEREBY CERTIFY THAT I HAVE PERFORMED A SURVEY OF THE FOLLOWING DESCRIBED PROPERTY
 LOTS 7, 8, BLOCK 117, ANCHORAGE ORIGINAL TOWNSHIP
 ANCHORAGE RECORDING DISTRICT, ALASKA, AND THE
 VISIBLE IMPROVEMENTS SITUATED THEREON ARE WITHIN
 THE PROPERTY LINES AND NO VISIBLE ENCROACHMENTS
 EXIST OTHER THAN NOTED.
 DATED AT ANCHORAGE, ALASKA THIS 16TH DAY

THE INFORMATION HEREON IS FOR THE USE OF LENDING INSTITUTIONS SPECIFICALLY TO SHOW ANY CONFLICTS BETWEEN EXISTING STRUCTURES AND PLATTED LOT LINES AND/OR EASEMENTS; AND IS NOT TO BE USED FOR POSITIONING ADDITIONAL STRUCTURES, IMPROVEMENTS, OR FENCE LINES. EASEMENTS OF RECORD, OTHER THAN THOSE APPEARING ON THE RECORD PLAT, ARE NOT SHOWN

AB-03

February 25, 2019

3420 North Shore Dr
Anchorage, Alaska 99502

AMCO
550 West Seventh Ave, Suite 1600
Anchorage, Alaska 99501

RE: Security Plan

Dear Carrie Craig:

The following security plan will be implemented by AK Alchemist at the address of 103 E 4th Ave, Anchorage, Alaska 99501.

- 1) All State, Federal, and Local Laws will be followed.
- 2) The consumption areas are sectioned off with either a glass wall, steel wall, or decorative railing.
- 3) All Serving Employees will be TAP certified.
- 4) 100% ID check is implemented when we host an event.
- 5) Security cameras are installed
- 6) We have a trained staff that knows how to assess and prevent patron intoxication
- 7) Persons under the age of 21 are not allow to consume alcohol
- 8) Any persons under 21 are not allowed to sit at the "bar area" on the north bar.
- 9) Proper signage will be posted in accordance with the Alaska Statutes.

This security plan will be posted for all employees and the public.

Best Regards,



Adam Blomfield
AK Alchemist, Owner
907 632-6566
Adam@blomfieldcompany.com

AMCO
FEB 25 2019



Alaska Alcoholic Beverage Control Board

Form AB-03: Restaurant Designation Permit Application

Section 5 - Certifications and Approvals

Read each line below, and then sign your initials in the box to the right of each statement:

Initials

I have included with this form a detailed floor plan of the proposed designated and undesignated areas of the licensed business for purposes of this application. I understand that this diagram is different than my licensed premises diagram.

AS

I have included with this form a menu, or an expected menu, listing the meals to be offered to patrons.

AS

I certify that the license for which I am requesting designation is either a beverage dispensary, club, recreational site, golf course, or restaurant or eating place license.

AS

I declare under penalty of perjury that this form, including all attachments and accompanying schedules and statements, is true, correct, and complete.


Ad
Signature of licensee

[Signature]
Signature of Notary Public

Alan Babinfield
Printed name of licensee

Notary Public in and for the State of Alaska

My commission expires: 6/06/2022

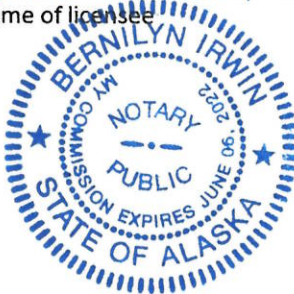

Subscribed and sworn to before me this 24 day of December, 2018.

Local Government Review (to be completed by an appropriate local government official):

Approved Disapproved

Signature of local government official

Date

Printed name of local government official

Title



Alaska Alcoholic Beverage Control Board

Form AB-03: Restaurant Designation Permit Application

AMCO Enforcement Review:

Signature of AMCO Enforcement Supervisor

Printed name of AMCO Enforcement Supervisor

Enforcement Recommendations:

AMCO Director Review:

Approved Disapproved

Signature of AMCO Director

Printed name of AMCO Director

Date

Limitations:



Winter Hours: 9AM- 12AM

Location: Alaska Regional Emergency
2801 Debarr Road, Anchorage, AK 99508

Contact for pickup orders: 907.868.5005

Hot Sandwiches \$10

SPICY YETI: ROASTED TURKEY BREAST, BACON, JALAPENO JACK, HAVARTI, JALAPENOS, FRANK'S RED HOT SAUCE, SPICY 3 PEPPER SAUCE, GRILLED ON MARBLE RYE BREAD.

CHICKEN CAPRESE: ROASTED CHICKEN BREAST, TOMATO, MOZZARELLA, BASIL PESTO, BALSAMIC VINEGAR, GRILLED ON ROSEMARY BREAD.

SPICY ROAST BEEF: ROAST BEEF, HORSERADISH CHEDDAR, DIJON, HORSERADISH SAUCE, GRILLED ON MARBLE RYE BREAD.

TURKEY PESTO: ROASTED TURKEY BREAST, PROVOLONE, RED ONION, ROASTED RED PEPPERS, BASIL PESTO, GRILLED ON ROSEMARY BREAD.

WILBER'S FATE: HAM, BACON, JALAPENO JACK CHEESE, DIJON MUSTARD, GRILLED ON MULTI-GRAIN BREAD.

Cold Sandwiches \$10

DAY AFTER THANKSGIVING: ROASTED TURKEY BREAST, HAVARTI, CRANBERRY SAUCE, ON MULTI-GRAIN BREAD.

HAM & SWISS: HAM, BACON, SWISS CHEESE, LETTUCE, TOMATO, RED ONION, SPICY DIJON MUSTARD, & MAYO ON MARBLE RYE BREAD.

GREEK CHICKEN: ROASTED CHICKEN BREAST, FETA, CUCUMBERS, TOMATO, RED ONION, TZATZIKI, ROASTED GARLIC HUMMUS, ON ROSEMARY BREAD.

SPICY T.B.A.: ROASTED TURKEY BREAST, BACON, JALAPENO JACK CHEESE, AVOCADO, TOMATO, RED ONION, LETTUCE, SPICY 3 PEPPER SAUCE, ON MULTI-GRAIN BREAD.

ROAST BEEF: ROAST BEEF, HORSERADISH CHEDDAR, LETTUCE, TOMATO, RED ONION, SPICY DIJON, MAYO, ON MARBLE RYE BREAD.

Veggie Sandwiches -\$10

GARDEN VEGGIE SANDWICH: HUMMUS, 3 PEPPER SAUCE, PEPPERJACK, CUCUMBER, TOMATO, ONION, LETTUCE, AVOCADO, SERVED COLD ON MULTI-GRAIN BREAD.

\$4 BOWL OF SOUP

ROTATING FLAVORS: TOMATO BASIL, TURKEY CORN CHOWDER, TURKEY WILD RICE, CLAM CHOWDER, & HEARTY BEEF CHILI.