Alcohol and Marijuana Control Office
550 W 7th Avenue, Suite 1600
Anchorage, AK 99501
marijuana.licensing@alaska.gov
https://www.commerce.alaska.gov/web/amco
Phone: 907.269.0350

Alaska Marijuana Control Board

Form MJ-02: Premises Diagram

What is this form?

A detailed diagram of the proposed licensed premises is required for all marijuana establishment license applications, per 3 AAC 306.020(b)(8). Your diagram must show all entrances and boundaries of the premises, restricted access areas, and storage areas, and dimensions. If your proposed premises is located within a building or building complex that contains multiple businesses and/or tenants, please provide an additional page that clearly shows the location of your proposed premises within the building or building complex, along with the addresses and/or suite numbers of the other businesses and/or tenants within the building or building complex. For those applying for a limited marijuana cultivation license, the proposed area(s) for cultivation must be clearly delineated.

The second page of this form is not required. Blueprints, CAD drawings, or other clearly drawn and marked diagrams may be submitted in lieu of the second page of this form. The first page must still be completed, attached to, and submitted with any supplemental diagrams. An AMCO employee may require you to complete the second page of this form if additional documentation for your premises diagram is needed.

This form must be completed and submitted to AMCO's main office before any license application will be considered complete.

	Yes	No
I have attached blueprints, CAD drawings, or other supporting documents in addition to, or in lieu of, the second page of this form.	☑	☐

Section 1 – Establishment Information

Enter information for the business seeking to be licensed, as identified on the license application.

Licensee:	Homer Budz, LLC	**License Number:**	12783		
License Type:	Standard Marijuana Cultivation Facility				
Doing Business As:	Homer Budz, LLC				
Premises Address:	67835 Virginia Ave				
City:	Homer	**State:**	AK	**ZIP:**	99603

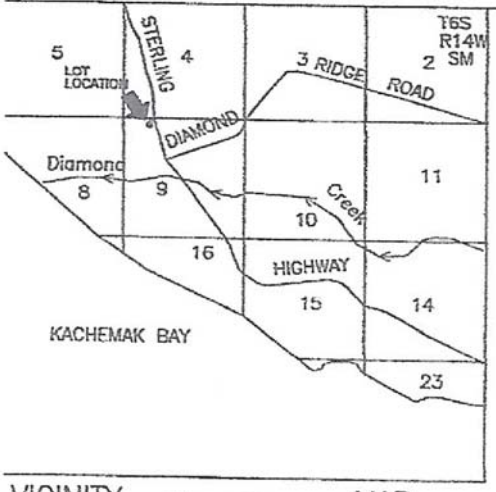

VICINITY 1" = 1.33 miles MAP

Cundiff Subd.
LOT 2 AS-BUILT SURVEY

Of Lot 2 Cundiff Subd, HRD 76-22, excepting Lot 2-A Cundiff Subd. Addn. No. 1, HRD 77-90.
Located in the NW1/4 Section 9, T6S R14W, SM.
Homer Recording District Kenai Peninsula Borough

Prepared by
Johnson Surveying
Box 27
Clam Gulch, Ak 99568

STATE OF ALASKA 49TH Gerard L Johnson GERARD L. JOHNSON 7328 - S REGISTERED PROFESSIONAL LAND SURVEYOR

SCALE 1" = 60' 14 May, 2015

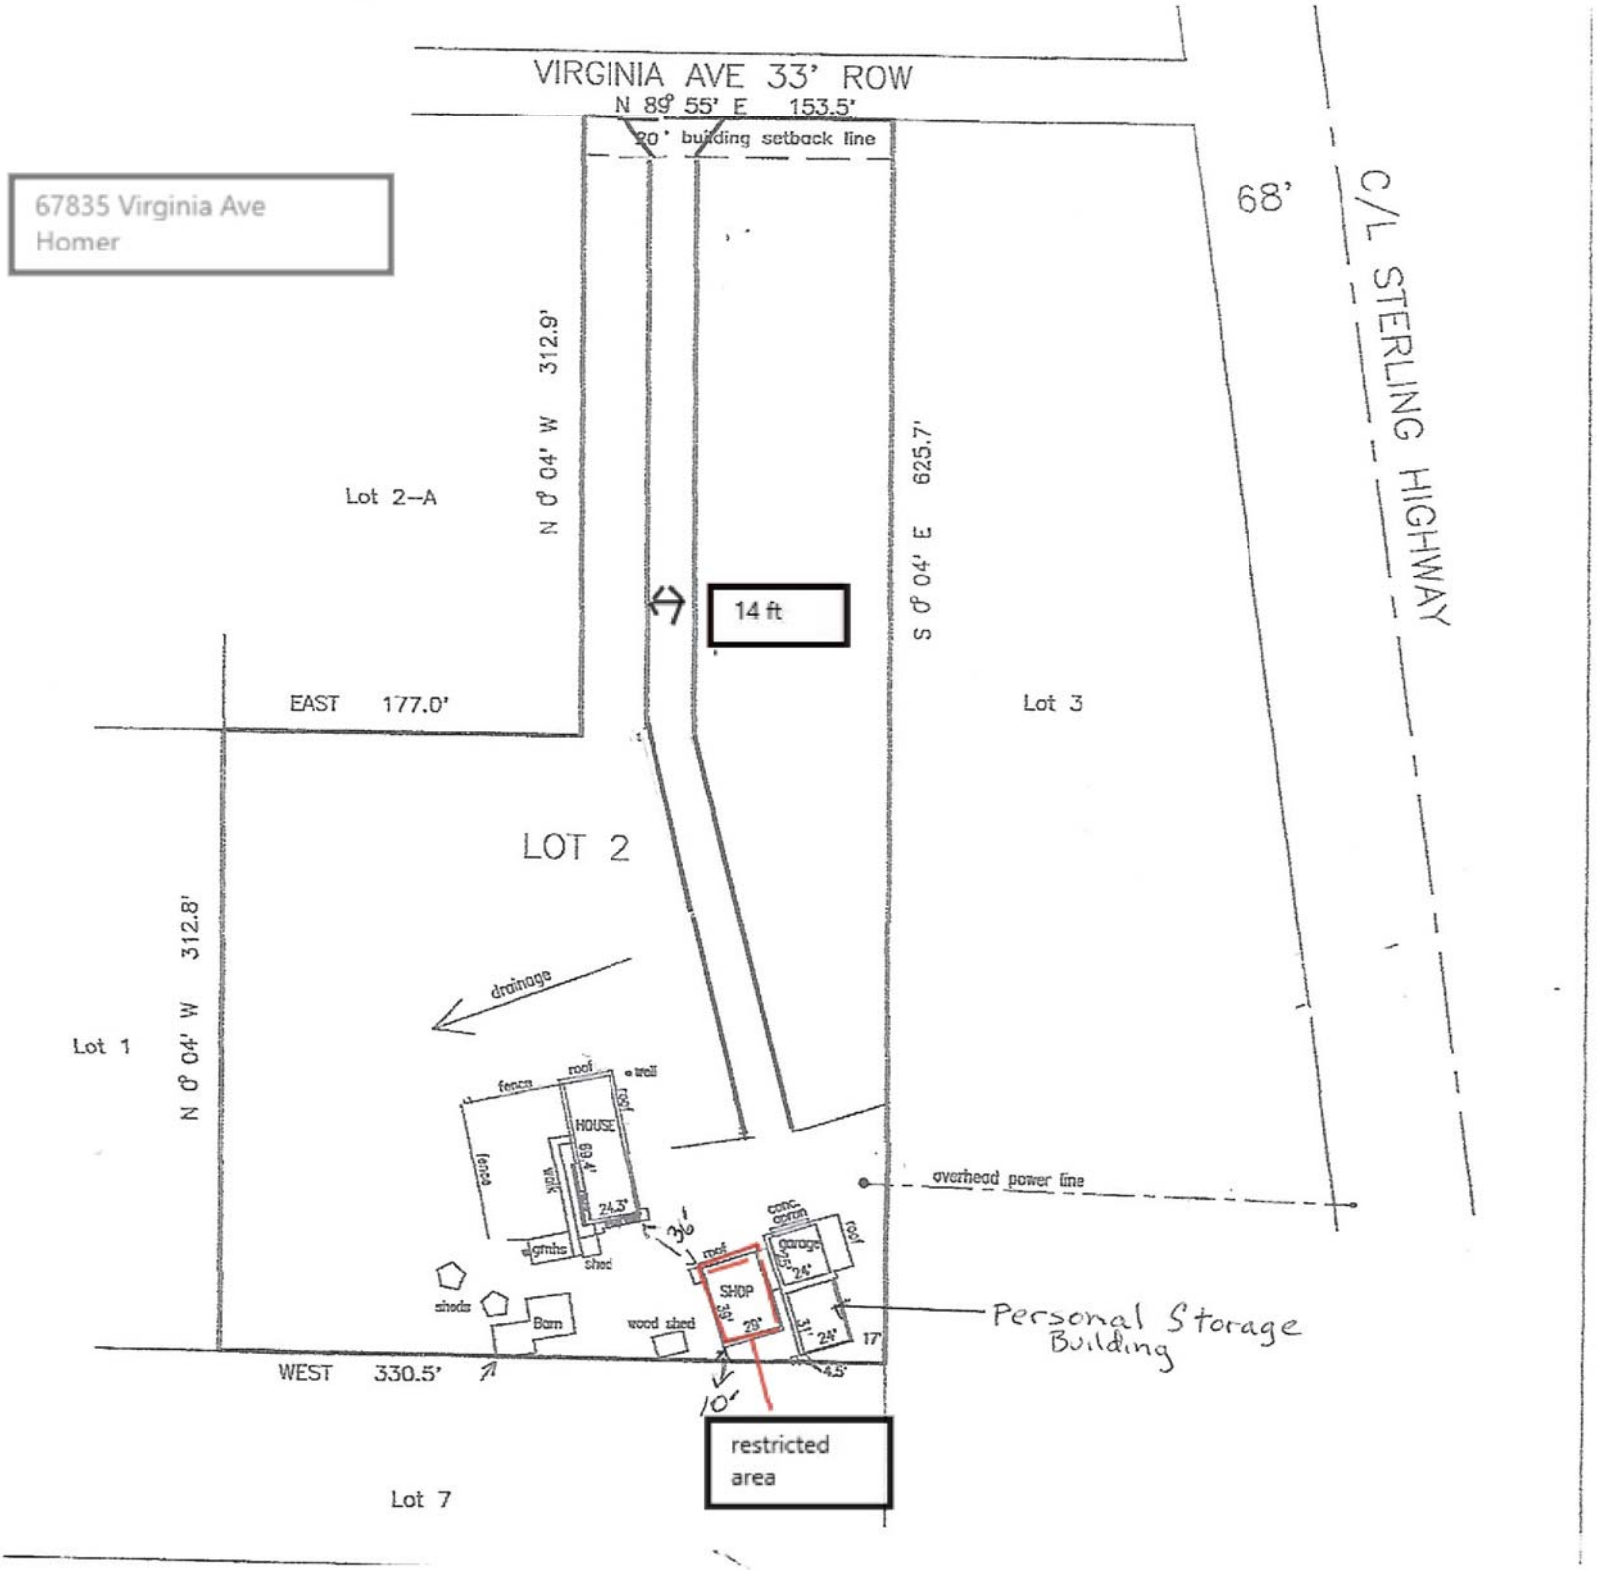

67835 Virginia Ave, Homer, AK

Enlarged Area of Plat –Cundiff Subdivision –Lot 2

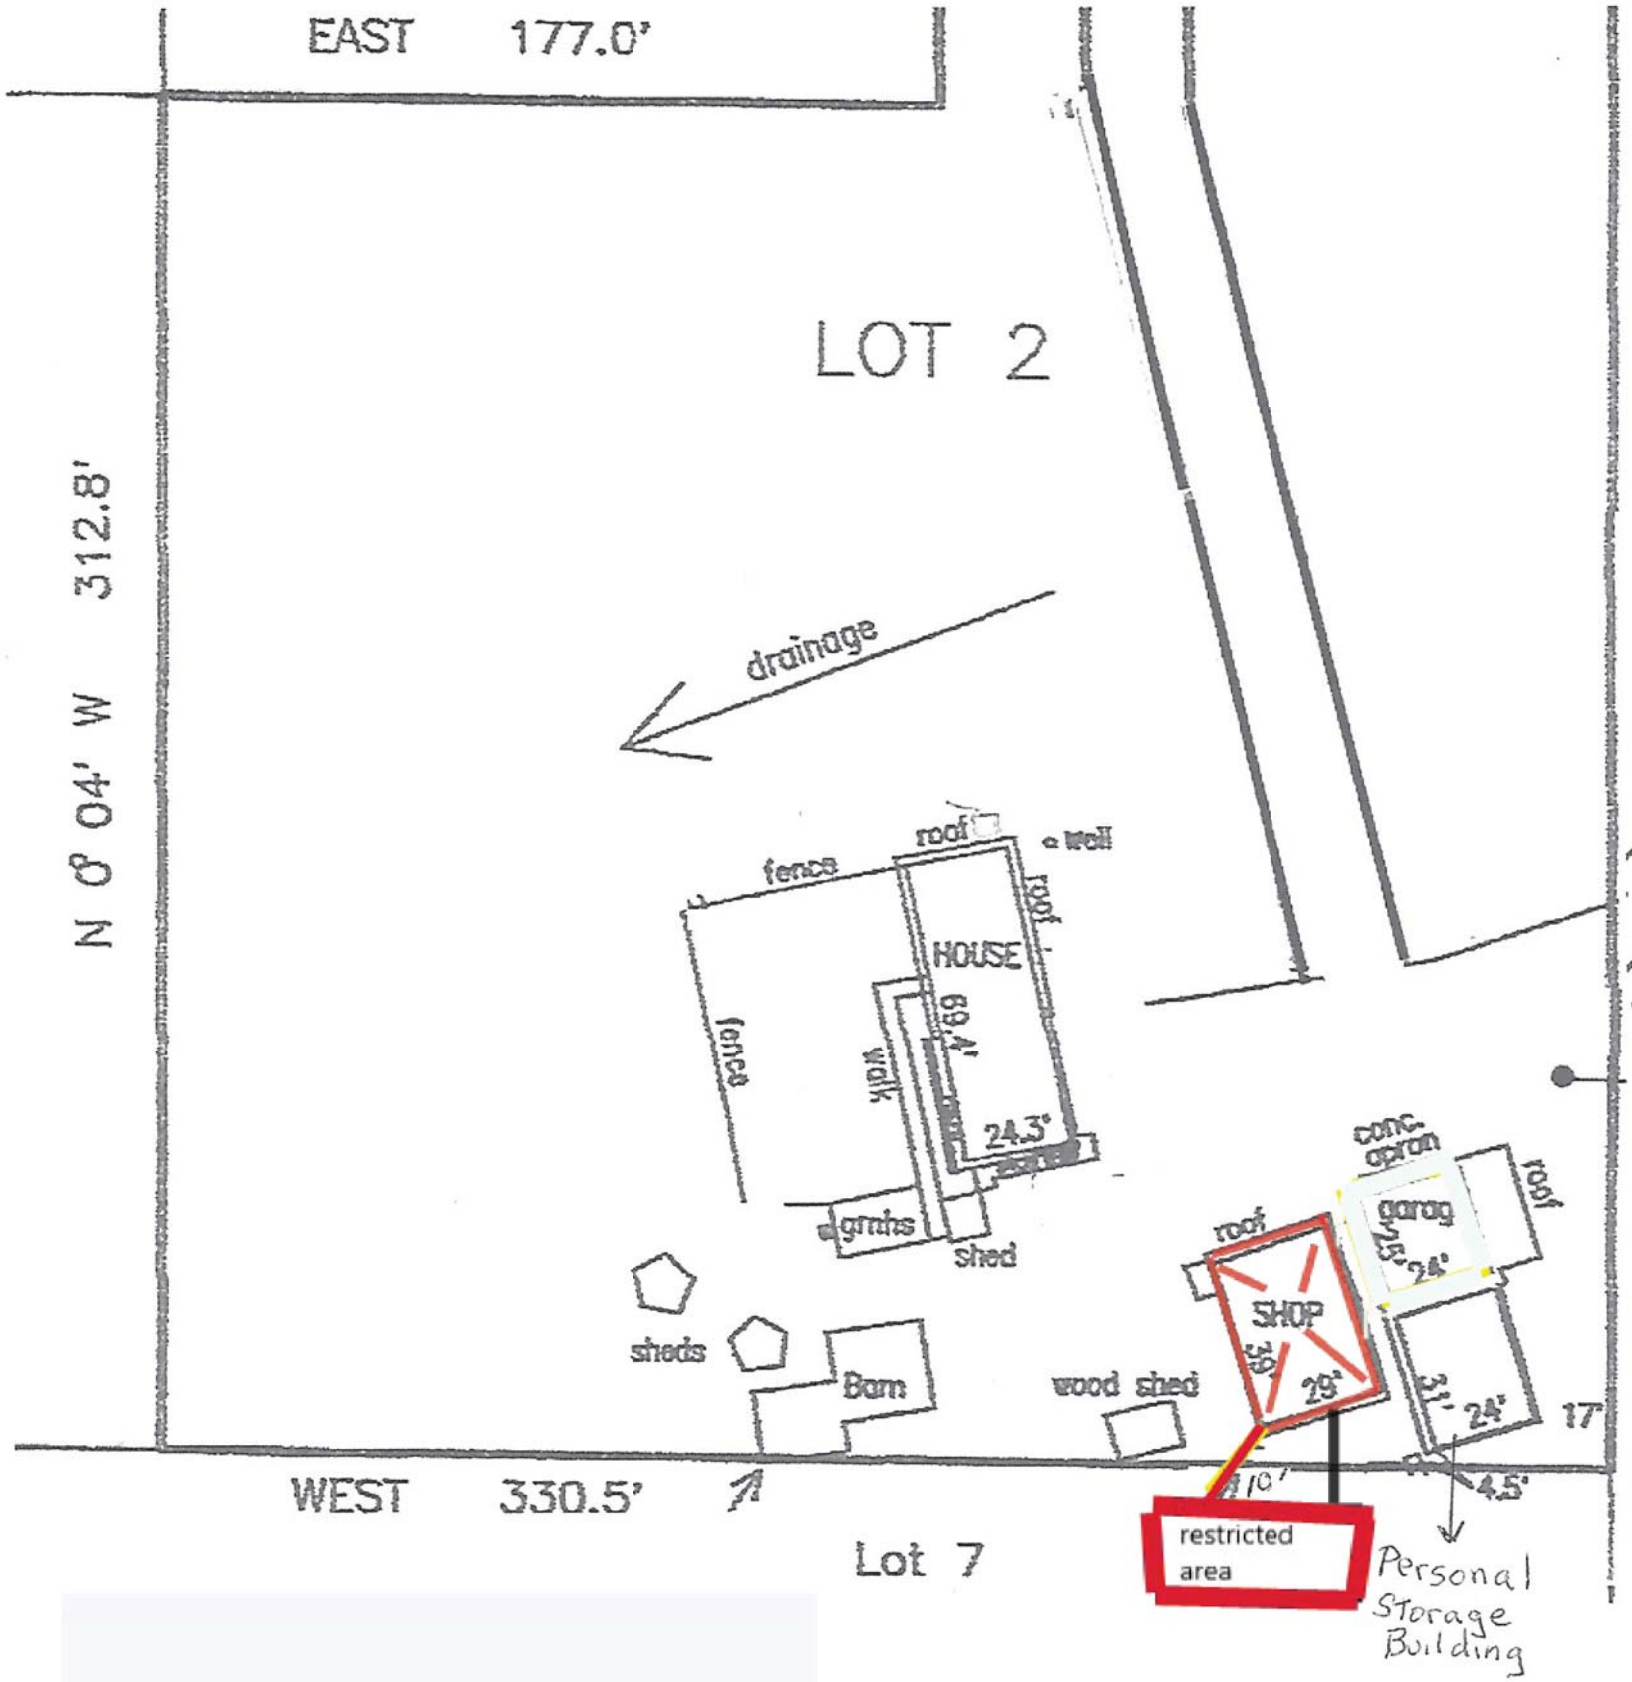

1st Floor

All of 1st Floor is restricted

motion light

Video camera

Emergency Lighting

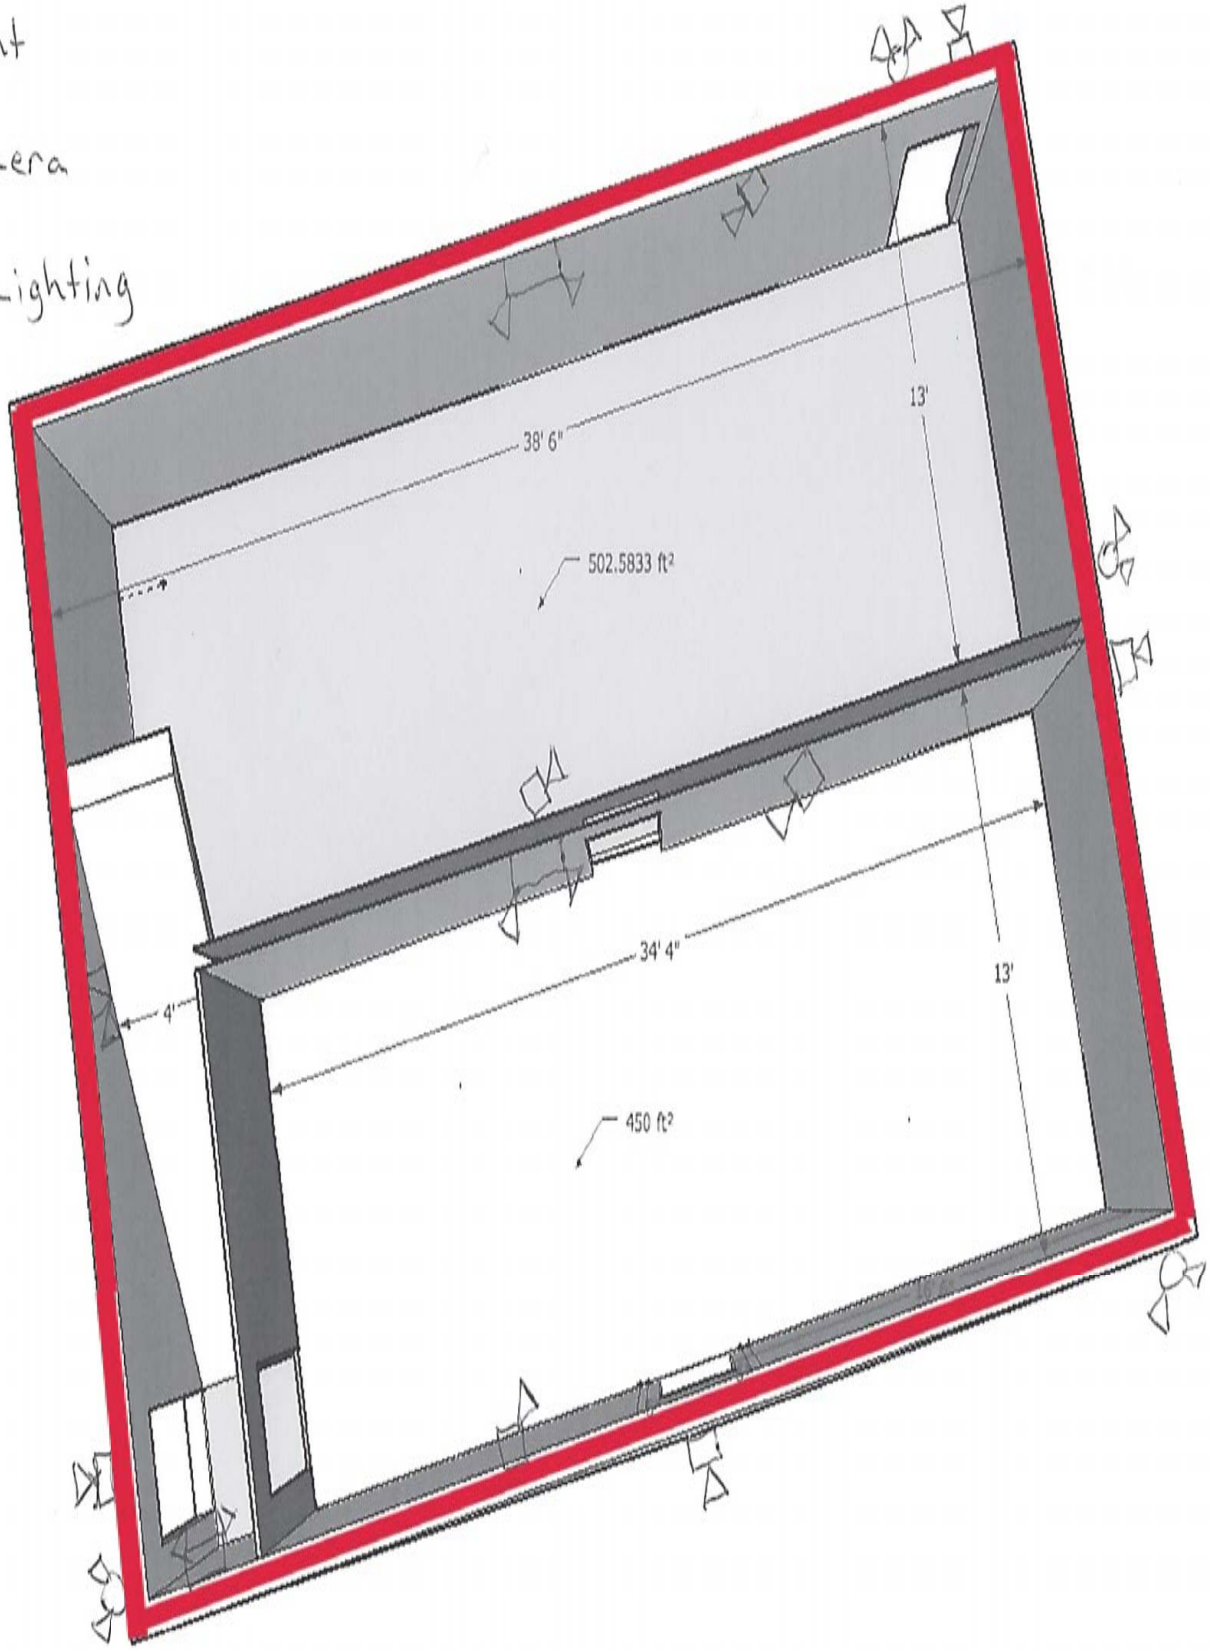

No storage in facility of 1st floor.

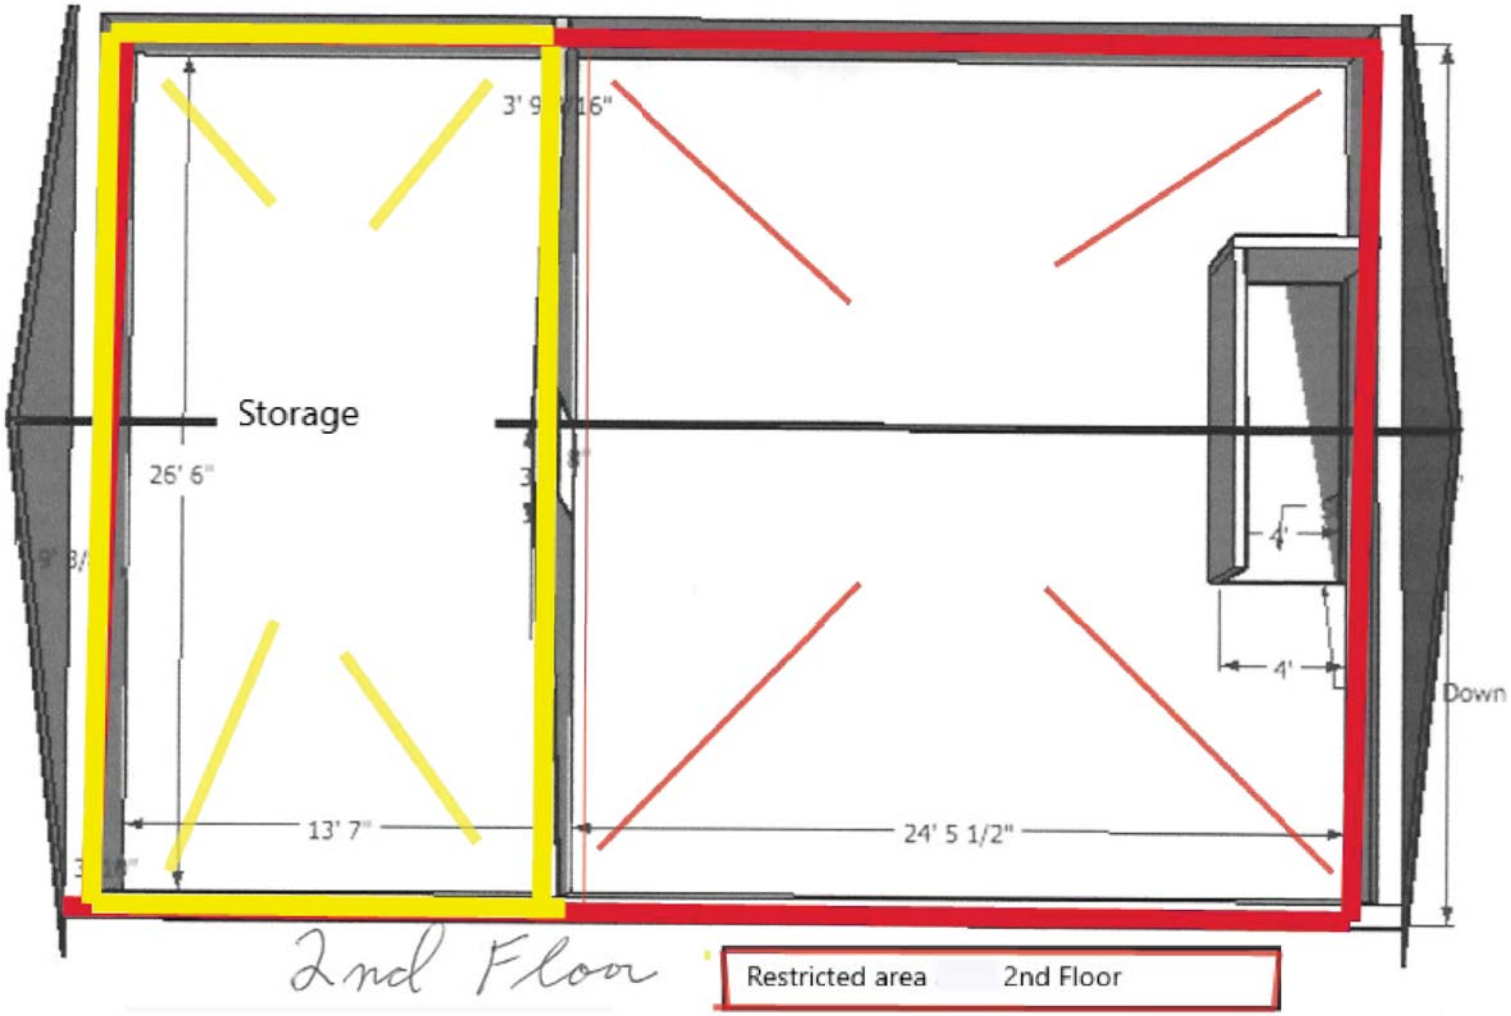

All of Yellow area on 2nd Floor will be used as storage

Upstairs

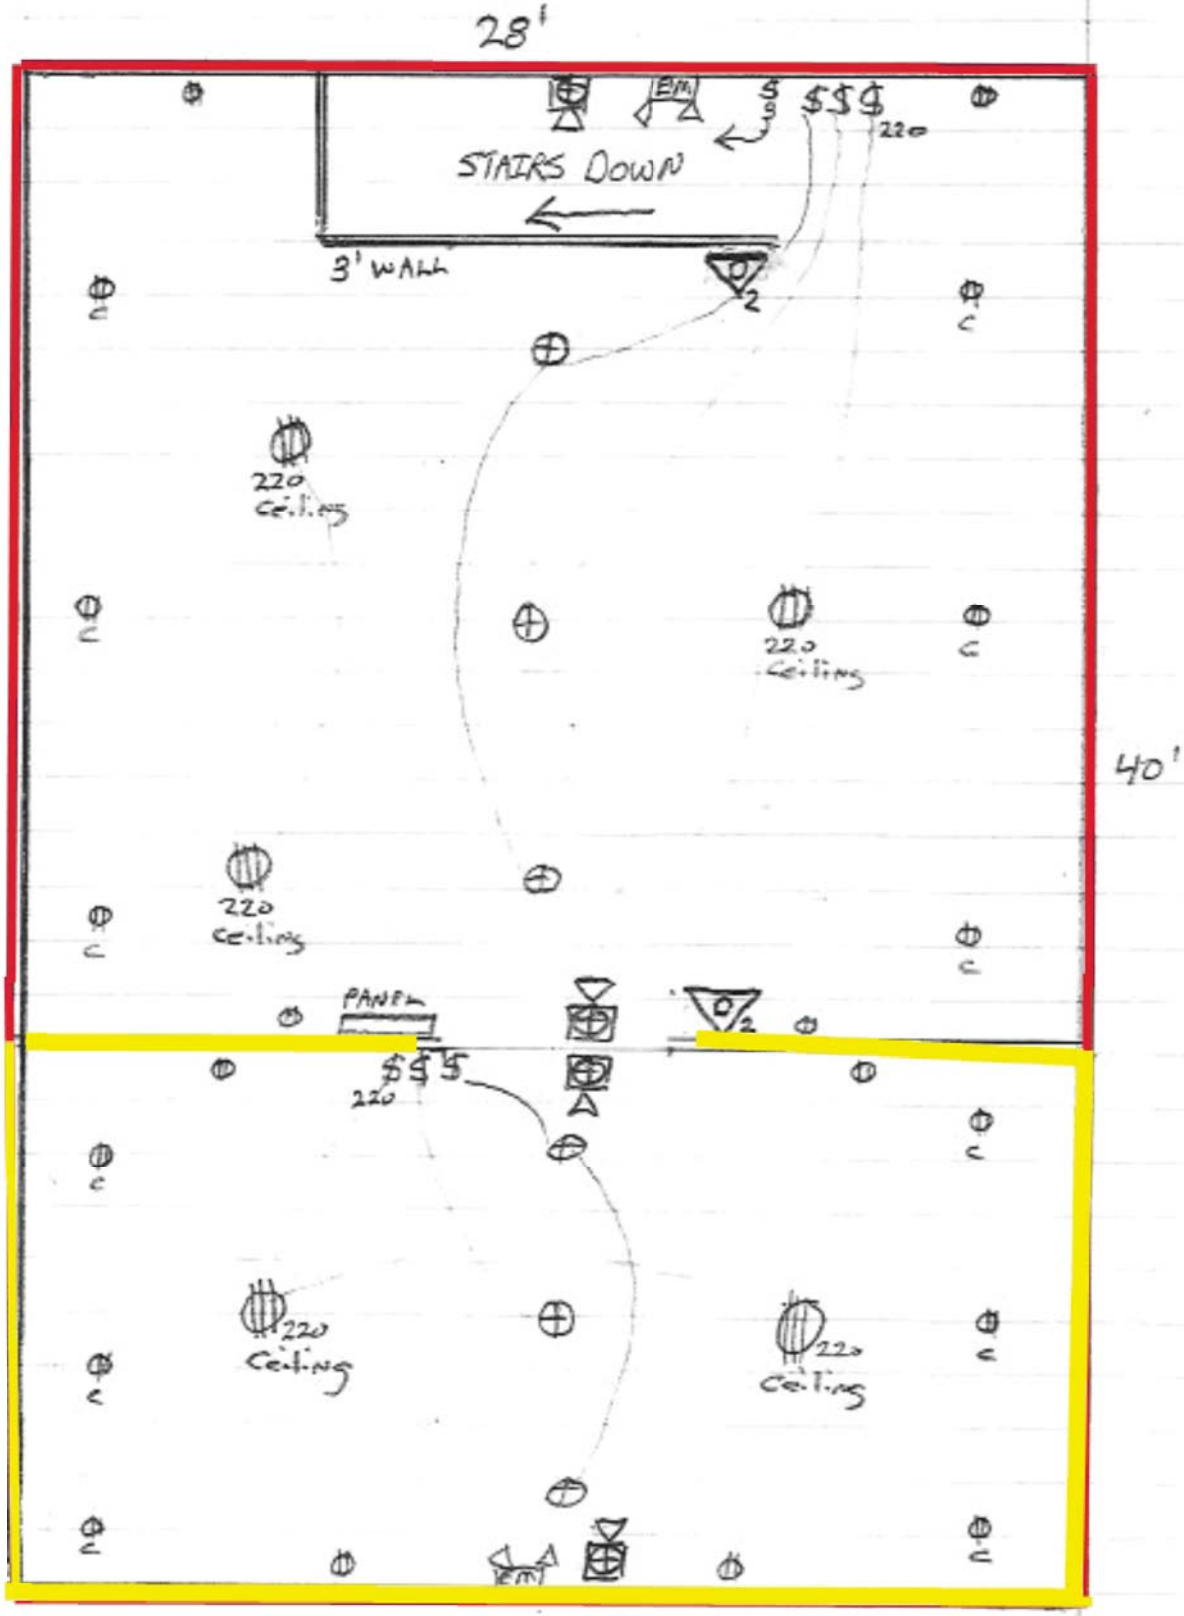

All of Yellow area on 2nd Floor will be used as storage.

Homer Budz, LLC - Building

$ - Switch
$3 - 3way Switch
$220 - 2 pole Switch
⦶ - wall recpt.
⦶c - Ceiling recpt.
⦶ - 220 recpt.
⊕ - Ceiling light
⊕ - wall light
EM - Emergency Light Pack
FX - Fire Extinguisher
Electrical Panel
METER METER BASE
Camera
D2 - Fire Extinguisher Dry 2½

Electrical components

Down stairs	Number of items	amps ea	total amps	volts		
Gavita DE 750	32	7.55	[illegible]	120,8	240 @ 3,8	http://gavita-holla
Fan	4	0.97	3.88	120		
Ceiling light	14	0.2	2.8	120	3/room and 2 for hall	http://www.home-
Wall fans	8	0.5	4	120		https://www.hydr
Cameras	8	0.04	0.32	120		
Controllers Gavita Lights	2	0.2	0.4	120		
Heaters 1500 watt for humidity control	4	12.5	50	120		https://www.princ
Motion lights	3	0.2	0.6			
			0			
Total			303.6			

Upstairs	number	amps ea	Total amps	volts	
Gavita DE 750	4	7.55	[illegible]	15,1	240 @ 3,8
Controller for Gavita Lights	2	0.2	0.4	120	
Cameras	4	0.04	0.16	120	
Fans inline exhaust	3	0.97	2.91	120	
Controller for Gavita Light	1	0.2	0.2	120	
Fans wall Oscillating	3	0.5	1.5	120	
Ceiling lights LED 4' dual bulb	6	0.2	1.2		
			0		
			0		
			0		
Total			36.57		
Total both floors			340.17	=	171 AMPS @ 240V