Alcohol & Marijuana Control Office
550 W 7th Avenue, Suite 1600
Anchorage, AK 99501
marijuana.licensing@alaska.gov
https://www.commerce.alaska.gov/web/amco
Phone: 907.269.0350

Alaska Marijuana Control Board

Cover Sheet for Marijuana Establishment Applications

What is this form?

This cover sheet **must** be completed and submitted any time a document, payment, or other marijuana establishment application item is emailed, mailed, or hand-delivered to AMCO's main office.

Items that are submitted without this page will be returned in the manner in which they were received.

Section 1 – Establishment Information

Enter information for the business seeking to be licensed, as identified on the license application.

Licensee:	H.E. Holdings, LLC	**License Number:**	12488		
License Type:	Standard Marijuana Cultivation Facility				
Doing Business As:	THIRDSTATE				
Physical Address:	200 Pheasant Farm Road				
City:	Fairbanks	**State:**	AK	**Zip Code:**	99712
Designated Licensee:	Haley Essig				
Email Address:	haley@thirdstate.co				

Section 2 – Attached Items

List all documents, payments, and other items that are being submitted along with this page.

Attached Items:	MJ-02 -Greenhouse Diagram -Greenhouse plot plan -Indoor Diagram

OFFICE USE ONLY					
Received Date:		Payment Submitted Y/N:		Transaction #:	

Alcohol and Marijuana Control Office
550 W 7th Avenue, Suite 1600
Anchorage, AK 99501
marijuana.licensing@alaska.gov
https://www.commerce.alaska.gov/web/amco
Phone: 907.269.0350

Alaska Marijuana Control Board

Form MJ-02: Premises Diagram

What is this form?

A detailed diagram of the proposed licensed premises is required for all marijuana establishment license applications, per 3 AAC 306.020(b)(8). Your diagram must show all entrances and boundaries of the premises, restricted access areas, and storage areas, and dimensions. If your proposed premises is located within a building or building complex that contains multiple businesses and/or tenants, please provide an additional page that clearly shows the location of your proposed premises within the building or building complex, along with the addresses and/or suite numbers of the other businesses and/or tenants within the building or building complex. For those applying for a limited marijuana cultivation license, the proposed area(s) for cultivation must be clearly delineated.

The second page of this form is not required. Blueprints, CAD drawings, or other clearly drawn and marked diagrams may be submitted in lieu of the second page of this form. The first page must still be completed, attached to, and submitted with any supplemental diagrams. An AMCO employee may require you to complete the second page of this form if additional documentation for your premises diagram is needed.

This form must be completed and submitted to AMCO's main office before any license application will be considered complete.

	Yes	No
I have attached blueprints, CAD drawings, or other supporting documents in addition to, or in lieu of, the second page of this form.	☑	☐

Section 1 – Establishment Information

Enter information for the business seeking to be licensed, as identified on the license application.

Licensee:	HE Holdings, LLC	**License Number:**	12488		
License Type:	Standard Marijuana Cultivation				
Doing Business As:	ThirdState				
Premises Address:	200 Pheasant Farm Road				
City:	Fairbanks	**State:**	AK	**ZIP:**	99712

Greenhouse

Carbon Filtration System (Prospective)

100 Gal Water Reservoirs

Canopy

camera

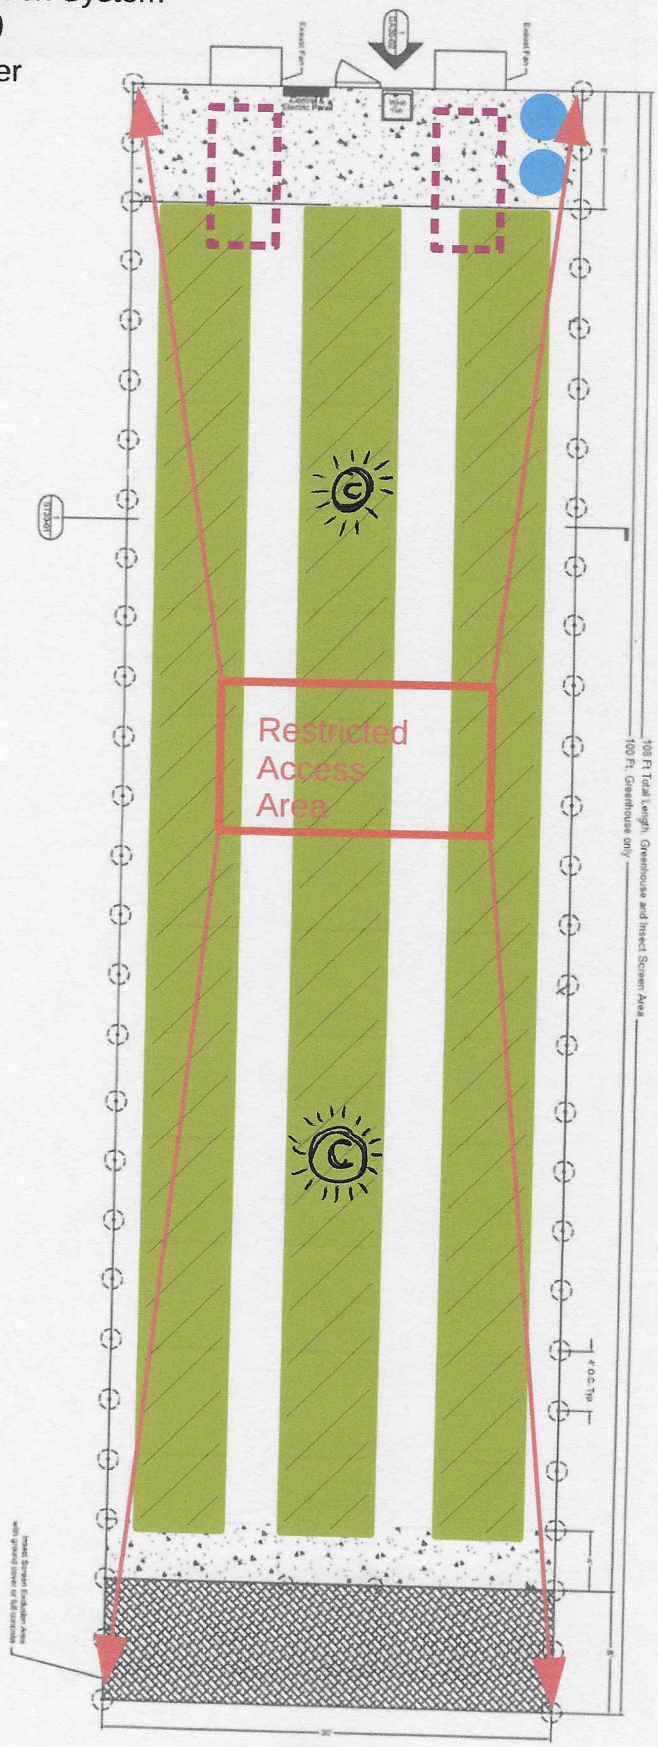

N

SEE PHEASANT FARM DETAIL BELOW

GREEN DIAMOND ENGINEERING

Drawn by:	G ST PIERRE
Registration:	AELC14658
Title:	PHEASANT FARM DETAIL
Date:	08/22/2017
Sheet:	1 of 1
Rev:	1

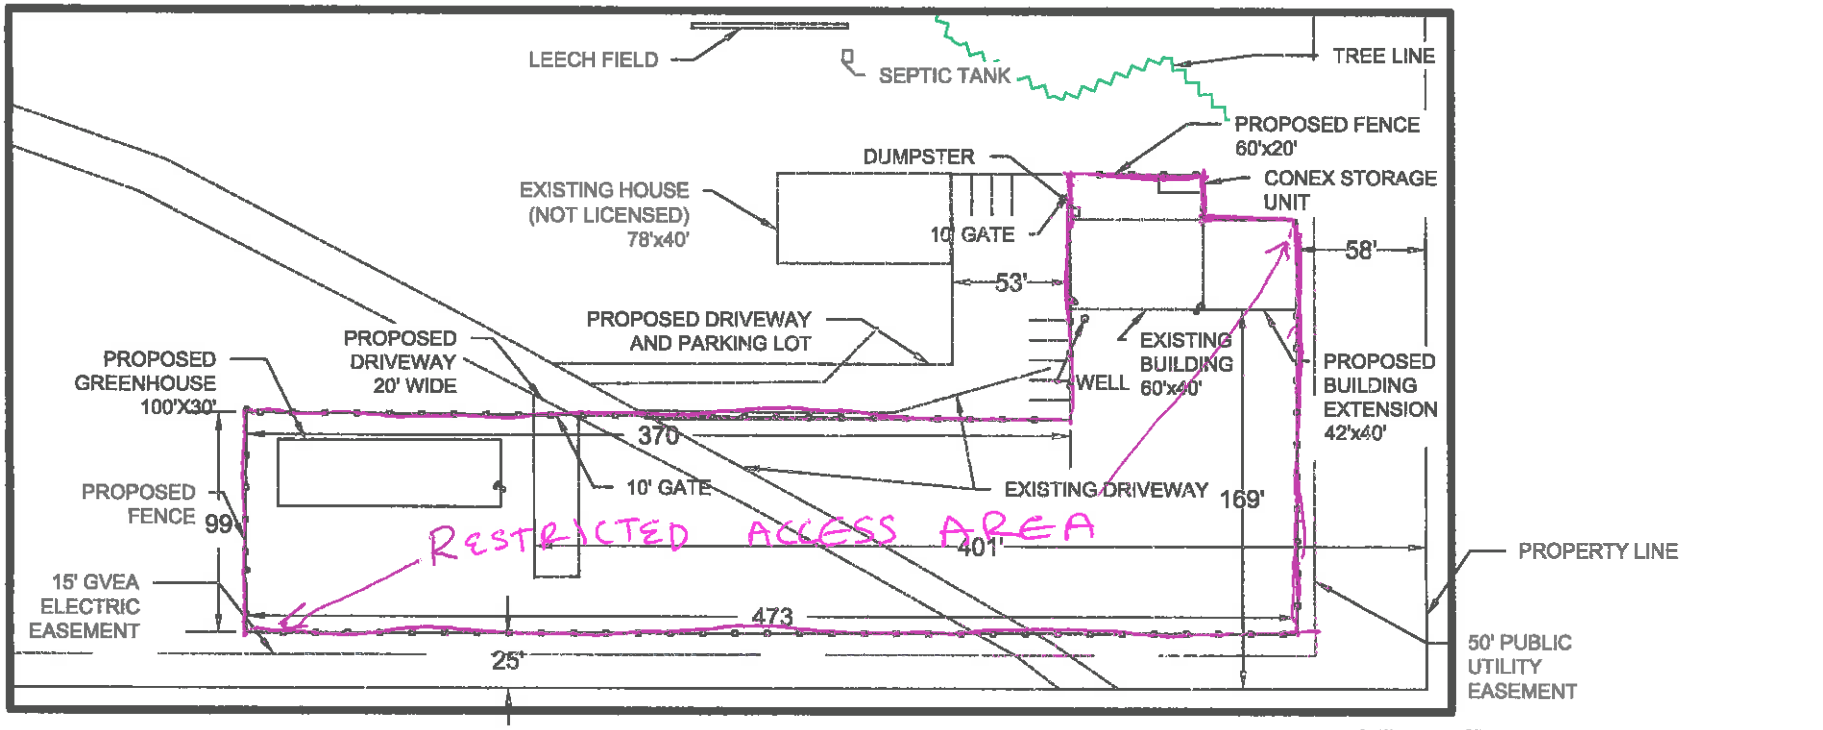

PHEASANT FARM DETAIL

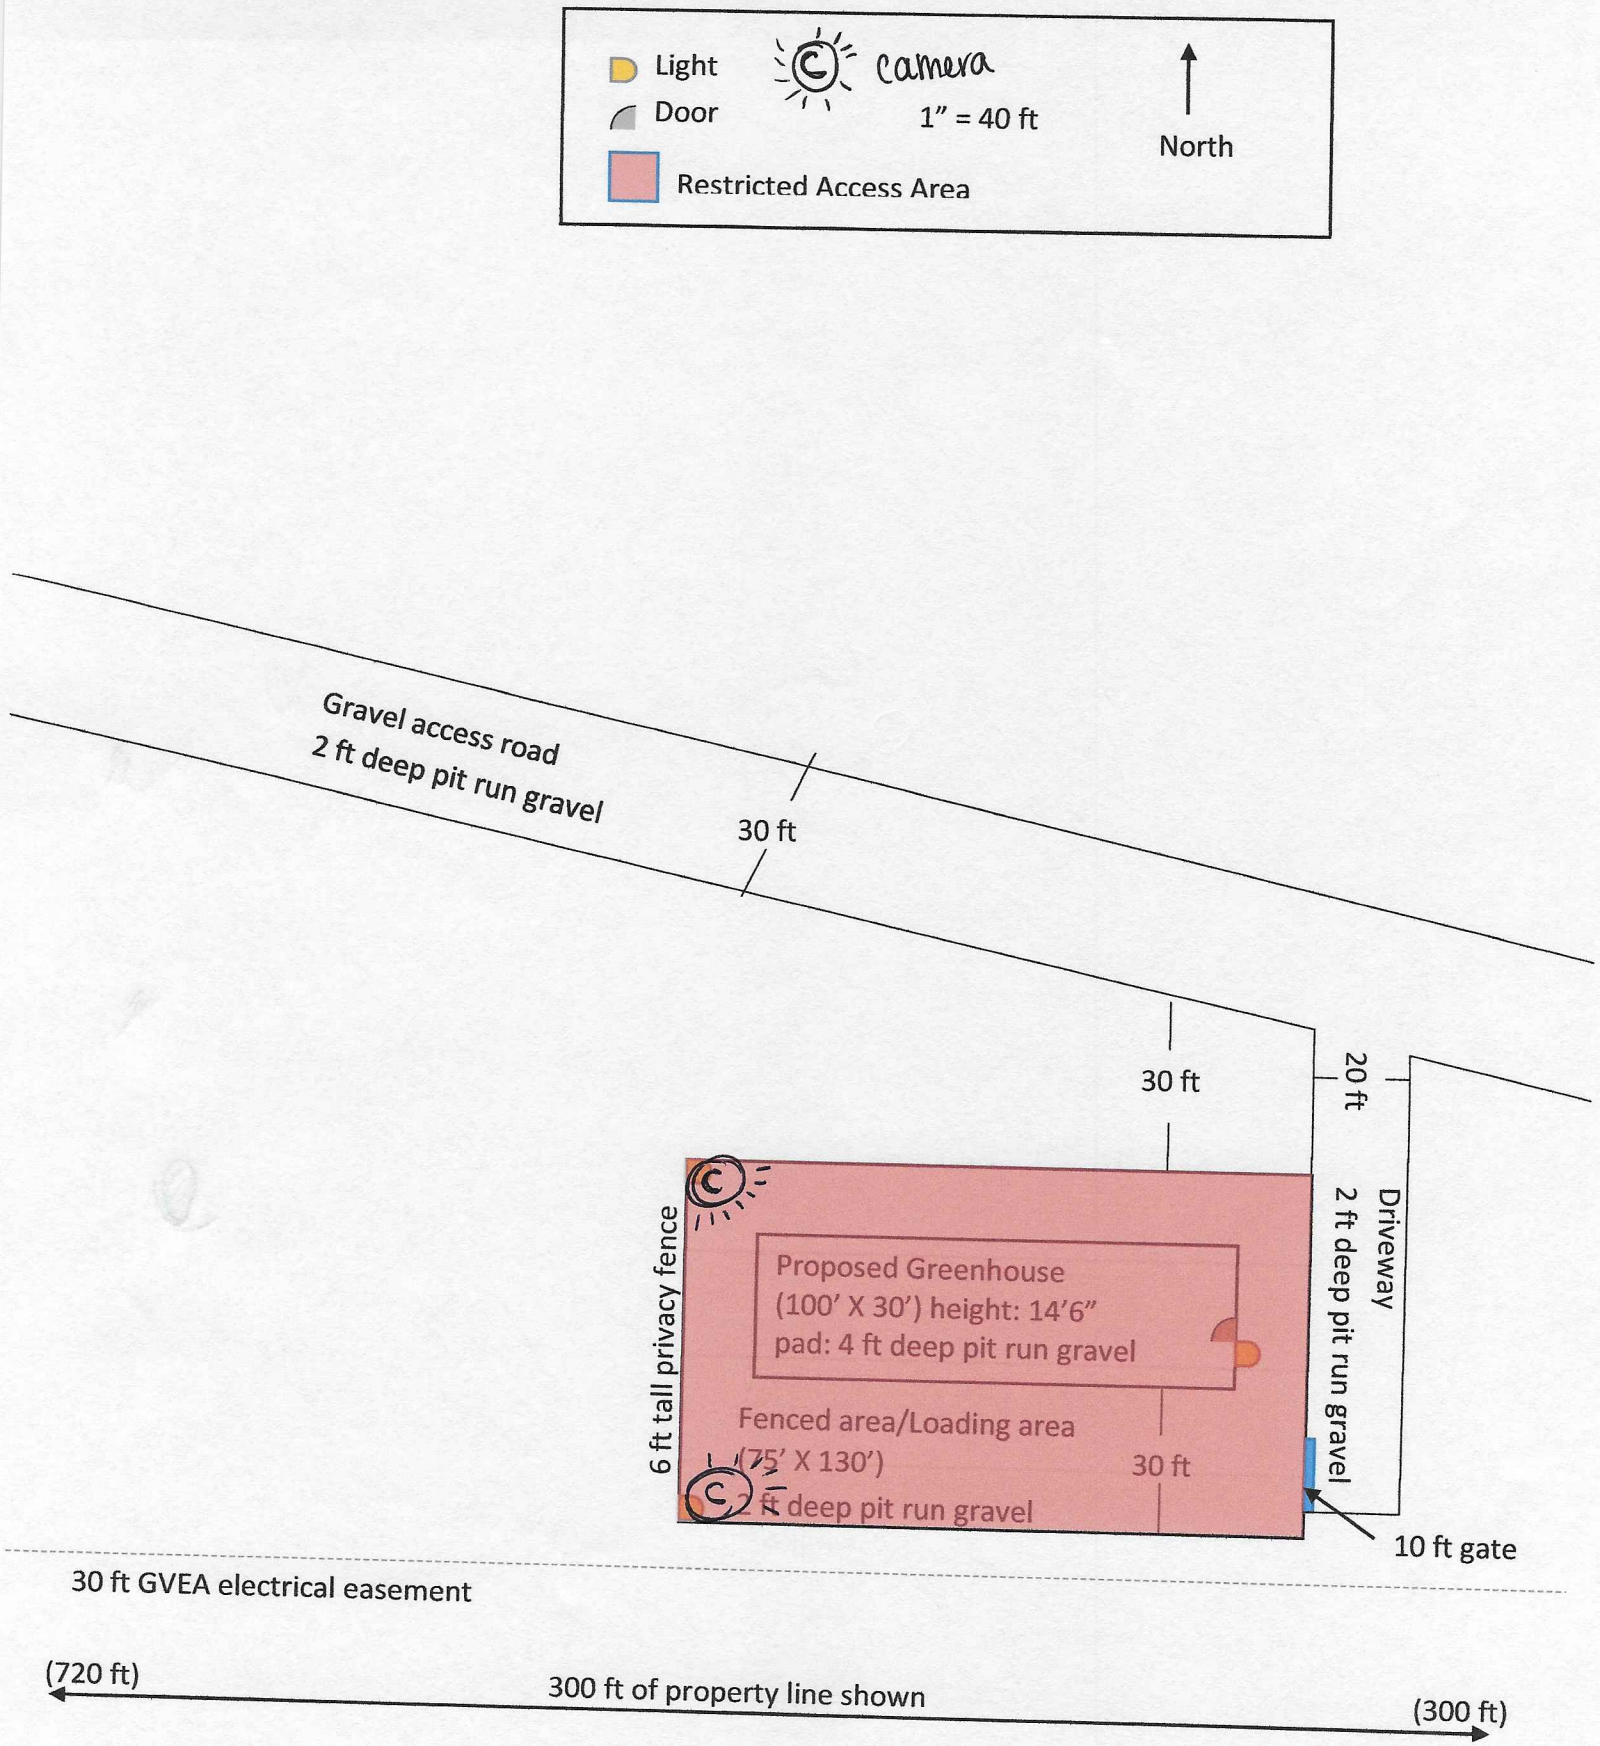
Light
camera
Door
1" = 40 ft
North
Restricted Access Area
Gravel access road
2 ft deep pit run gravel
30 ft
30 ft
20 ft
Driveway
2 ft deep pit run gravel
6 ft tall privacy fence
Proposed Greenhouse
(100' X 30') height: 14'6"
pad: 4 ft deep pit run gravel
Fenced area/Loading area
(75' X 130')
2 ft deep pit run gravel
30 ft
10 ft gate
30 ft GVEA electrical easement
(720 ft)
300 ft of property line shown
(300 ft)

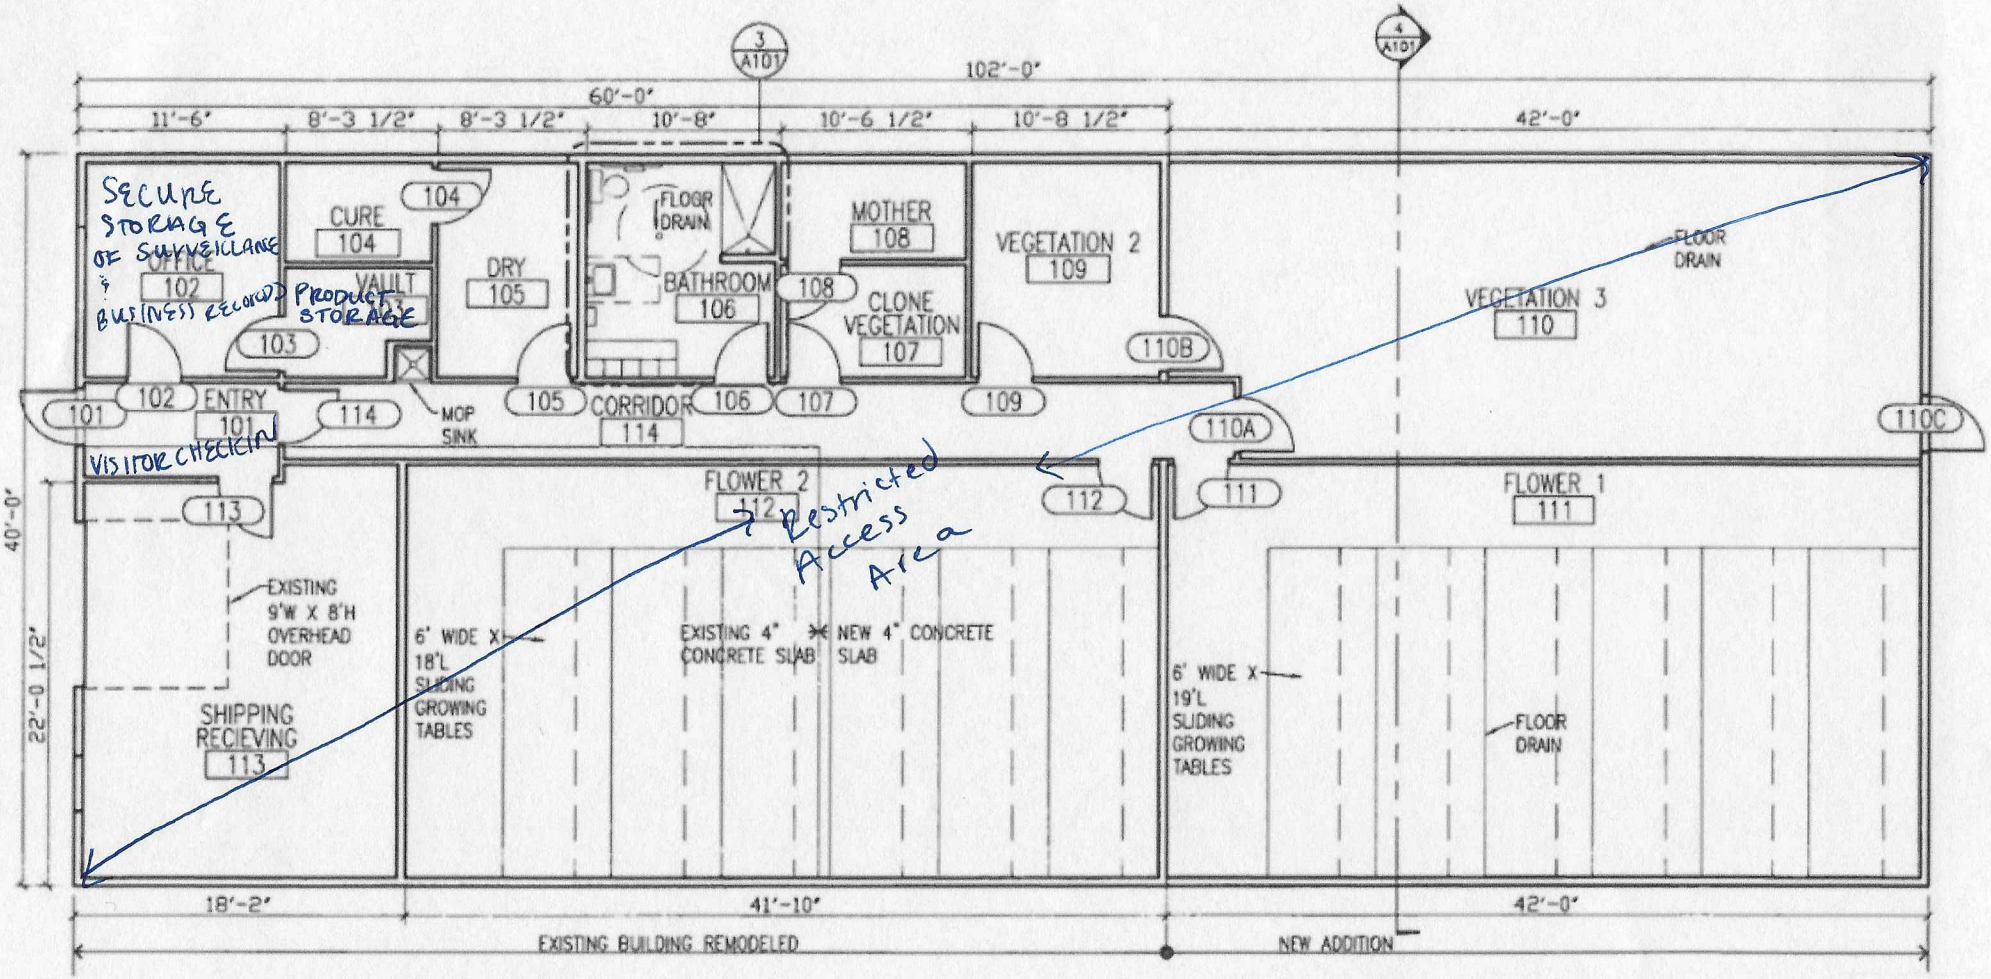

2
A101

FIRST FLOOR PLAN

1/8"=1'-0"

N

8 0 8 16

SCALE OF FEET

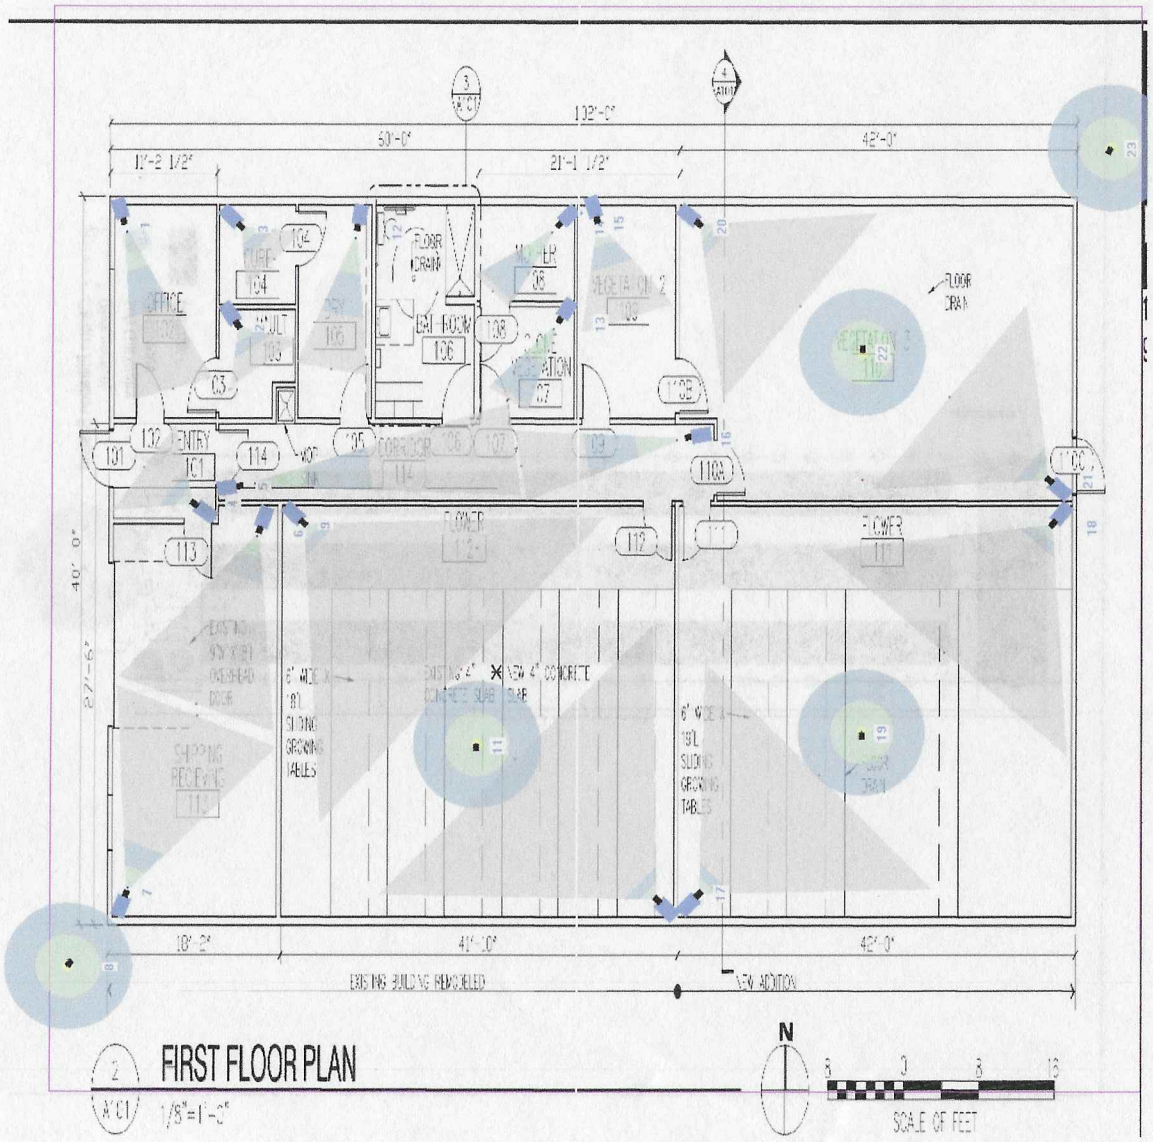

2 FIRST FLOOR PLAN

1/8"=1'-0"