Anchorage, AK 99501
marijuana.licensing@alaska.gov
https://www.commerce.alaska.gov/web/amco
Phone: 907.269.0350

Alaska Marijuana Control Board

Form MJ-02: Premises Diagram

What is this form?

A detailed diagram of the proposed licensed premises is required for all marijuana establishment license applications, per 3 AAC 306.020(b)(8). **All areas designated as the licensed premises of a single license must be contiguous.**

What must be submitted with this form?

Applicants must attach multiple diagrams to this form, including (as applicable):

- **Diagram 1:**
  a diagram showing only the licensed premises areas that will be ready to be **operational at the time of your preliminary inspection** and license issuance;

- **Diagram 2:**
  if different than Diagram 1, a diagram outlining **all areas for which the licensee has legal right of possession** (a valid lease or deed), and clearly showing those areas' relationship to the current proposed licensed premises *(details of any planned expansion areas do not need to be included; a complete copy of Form MJ-14: Licensed Premises Diagram Change must be submitted and approved before any planned expansion area may be added to the licensed premises);*

- **Diagram 3:**
  a **site plan or as-built of the entire lot**, showing all structures on the property and clearly indicating which area(s) will be part of the licensed premises;

- **Diagram 4:**
  an **aerial photo of the entire lot and surrounding lots**, showing a view of the entire property and surrounding properties, and clearly indicating which area(s) will be part of the licensed premises *(this can be obtained from sources like Google Earth)*; and

- **Diagram 5:**
  a diagram of the **entire building in which the licensed premises is located**, clearly distinguishing the licensed premises from unlicensed areas and/or premises of other licenses within the building. If your proposed licensed premises is located within a building or building complex that contains multiple business and/or tenants, please provide the addresses and/or suite numbers of the other businesses and/or tenants *(a separate diagram is not required for an establishment that is designating the entire building as a single licensed premises).*

This form, and all necessary diagrams that meet the requirements on Page 2 of this form, must be completed and submitted to AMCO's main office before any new or transfer license application will be considered complete.

Section 1 – Establishment Information

Enter information for the business seeking to be licensed, as identified on the license application.

Licensee:	ALASKA FROSTED FLOWERS, LLC.	**MJ License #:**		17952	
License Type:	STANDARD MARIJUANA CULTIVATION LICENSE				
Doing Business As:	ALASKA FROSTED FLOWERS, LLC.				
Premises Address:	495 W. SUNFLOWER DRIVE				
City:	WASILLA	**State:**	Alaska	**ZIP:**	99654

Received by AMCO 11.6.18

Form MJ-02: Premises Diagram

Section 2 – Required Information

For your security, do not include locations of security cameras, motion detectors, panic buttons, and other security devices.

The following details must be included in all diagrams:

- [x] License number and DBA
- [x] Legend or key
- [x] Color coding
- [x] Dimensions
- [x] Labels
- [x] True north arrow

The following additional details must be included in Diagram 1:

- [x] Surveillance room
- [x] Restricted access areas
- [x] Storage areas
- [x] Entrances, exits, and windows
- [x] Walls, partitions, and counters
- [x] Any other areas that must be labeled for specific license types

The following additional details must be included in Diagram 2:

- [x] Areas of ingress and egress
- [x] Entrances and exits
- [x] Walls and partitions

The following additional details must be included in Diagrams 3 and 4:

- [x] Areas of ingress and egress
- [x] Cross streets and points of reference

The following additional details must be included in Diagram 5:

- [ ] Areas of ingress and egress
- [ ] Entrances and exits
- [ ] Walls and partitions
- [ ] Cross streets and points of reference

N/A Entire Building is a Single licensed premises.

I declare under penalty of unsworn falsification that I have attached all necessary diagrams that meet the above requirements, and that this form, including all accompanying schedules, statements, and depictions is true, correct, and complete.

Signature of licensee

Michael Musbach

Printed name of licensee

Notary Public in and for the State of Alaska

My commission expires: 6-18-19

LANCE D. WELLS NOTARY PUBLIC STATE OF ALASKA

Subscribed and sworn to before me this 9th day of July, 2018.

License # 17962

Received by AMCO 11.6.18

Diagram #1

PLAN LEGEND (AMCO - CULTIVATION)

- CULTIVATION (RESTRICTED ACCESS AREA) & Licensed premises
- LICENSEE LEGAL OWNERSHIP AREA
- INV. — MARIJUANA INVENTORY
- M-S — MARIJUANA STORAGE
- Q — QUARANTINE AREA
- W-S — WASTE STORAGE

= Surveillance Equipment

= Restroom: Part of licensed premises, but not a restricted access area.

LICENSE #: 17952

NORTH

DBA: ALASKA FROSTED FLOWERS, LLC

Steel Building Construction

OVERHEAD DOOR

FLOWER ROOMS
3 Containers 8' x 40' each
total = 720 sq feet

PRIMARY ENTRANCE

VEG RACKS
240 sq. ft.

40'

GENERAL STORAGE

94'-6"

WORK AREA

BREAK AREA

REST ROOM

EMERGENCY EXIT

58'-5"

NOTES

- NO EXTERIOR WINDOWS

Surveillance Room Equipment

19'-3"

19'-1"

UPPER LEVEL

GROUND LEVEL

DRYING / CURING / STORAGE

3 FT WALKWAY

DRYING / CURING / STORAGE

FLOWER ROOM

36

22'-6"

10'

58'-7"

BASEMENT

total sq. ft. in basement under cultivation: 360 sq. ft.

NOTE: USE HALF INDICATED SCALE FOR 11X17 DRAWINGS

Determine

Received by AMCO 11.6.18

Determine DESIGN LLC AECL1613
903 W. NORTHERN LTS. BLVD # 206
ANCHORAGE, AK 99503
(907) 339-9100
determinedesign.com

Drawn: Daniel Clift
Date: 9/4/18
Time: 1:26 PM

STATE OF ALASKA — DANIEL CLIFT — 14104 — REGISTERED ARCHITECT

PROJECT TITLE: AMCO DIAGRAMS
PREPARED FOR: AK FROSTED FLOWERS, LLC
ADDRESS: 495 W Sunflower Cir. Wasilla, AK 99654

SHEET NUMBER: 1

AMCO DIAGRAMS

Diagram # 2

PLAN LEGEND (AMCO - CULTIVATION)

- CULTIVATION (RESTRICTED ACCESS AREA) & licensed premises
- LICENSEE LEGAL OWNERSHIP AREA
- INV. — MARIJUANA INVENTORY
- M-S — MARIJUANA STORAGE
- Q — QUARANTINE AREA
- W-S — WASTE STORAGE

NORTH

LICENSE #: 17952

DBA: ALASKA FROSTED FLOWERS, LLC

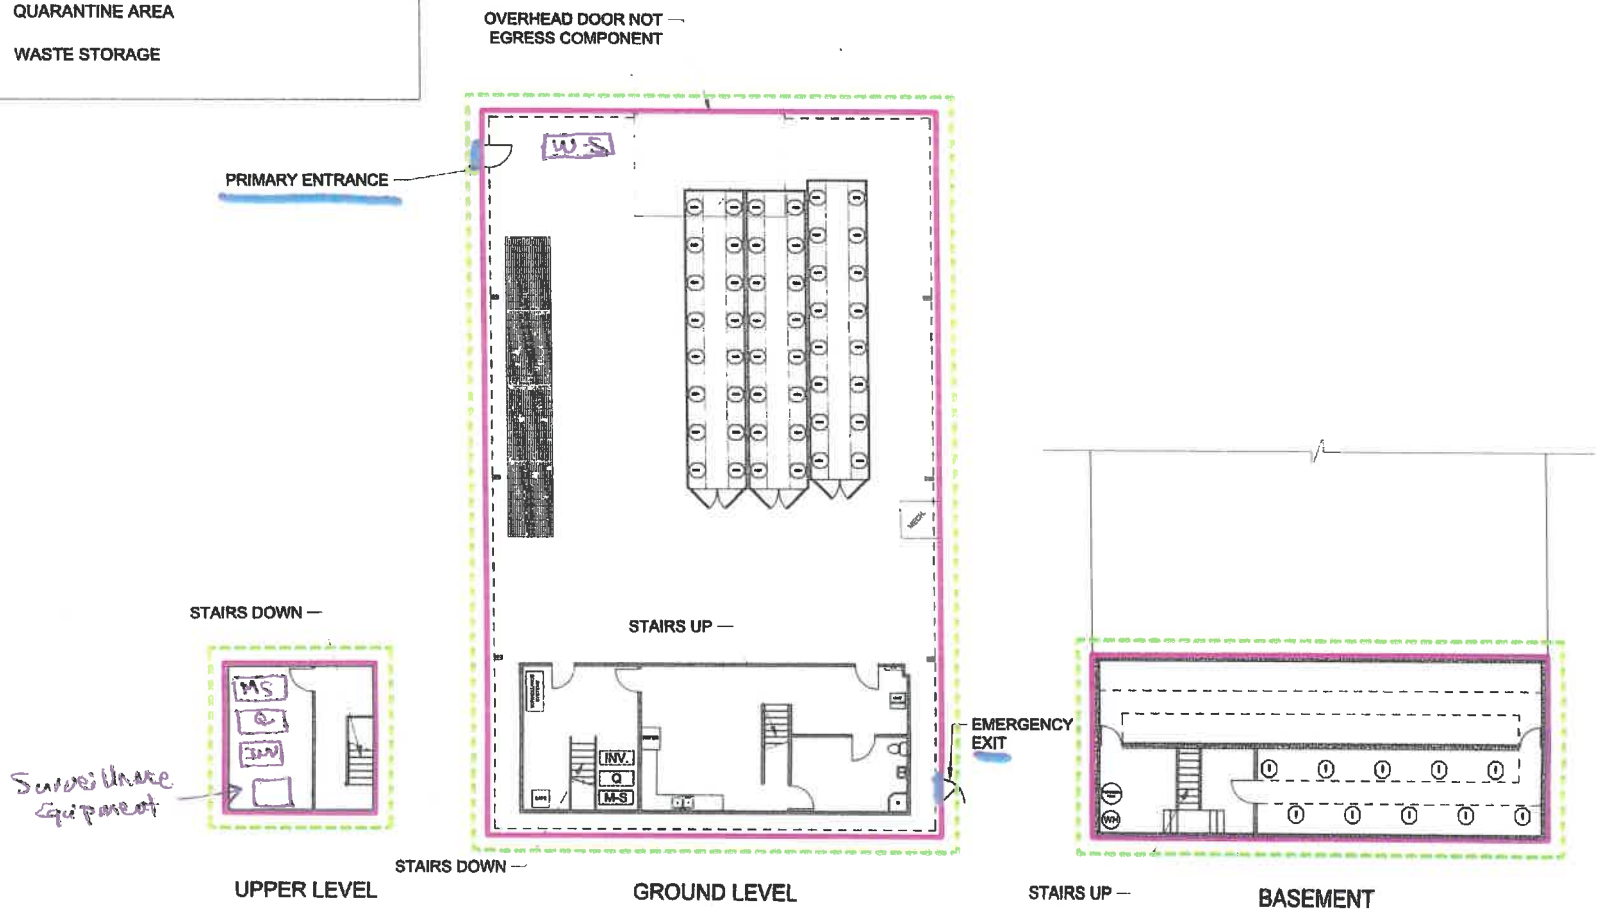

NOTE: USE HALF INDICATED SCALE FOR 11X17 DRAWINGS

Determine DESIGN LLC AECL1613
1. NORTHERN LIGHTS BLVD, SUITE 203
ANCHORAGE, AK 99503
907-339-9100
daniel@determinedesign.com

Drawn: Daniel Cliff
Date: 9/4/18
Time: 1:26 PM

STATE OF ALASKA
DANIEL H. CLIFF
- 14104

PROJECT TITLE: AMCO DIAGRAMS
PREPARED FOR: AK FROSTED FLOWERS, LLC
ADDRESS: 495 W Sunflower Cir. Wasilla, AK 99654

SHEET NUMBER: 2

AMCO DIAGRAMS

Diagram #3

PLAN LEGEND (AMCO - CULTIVATION)

- CULTIVATION (RESTRICTED ACCESS AREA) & Licensed premises.
- LICENSEE LEGAL OWNERSHIP AREA
- INV. — MARIJUANA INVENTORY
- M-S — MARIJUANA STORAGE
- Q — QUARANTINE AREA
- W-S — WASTE STORAGE

NORTH

LICENSE #: 17952

DBA: ALASKA FROSTED FLOWERS, LLC

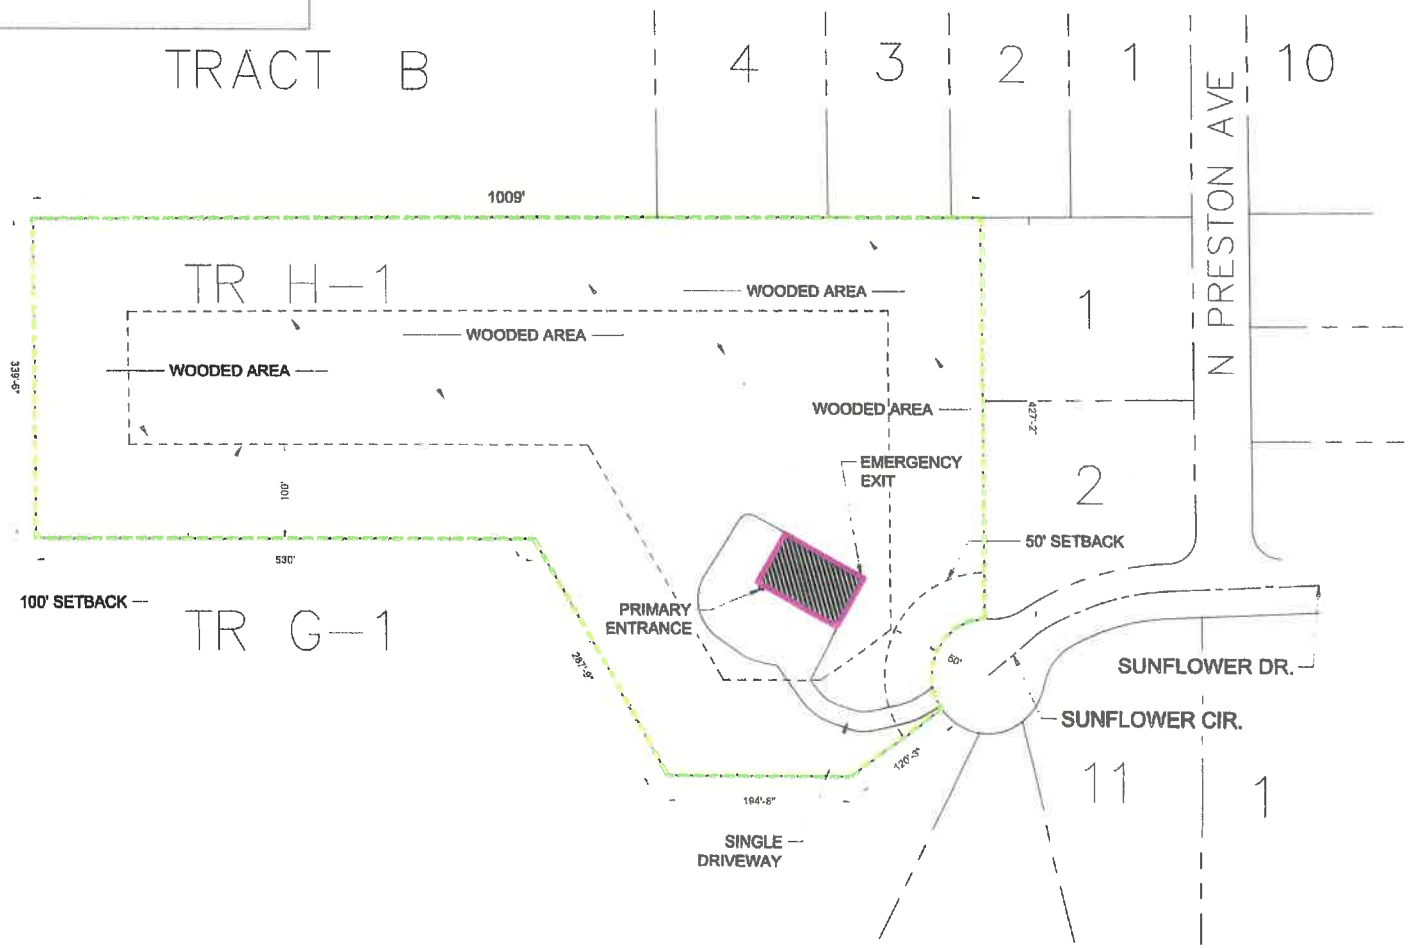

NOTE: USE HALF INDICATED SCALE FOR 11X17 DRAWINGS

Determine DESIGN LLC AECL1613
903 W. NORTHERN LTS. BLVD # 206
ANCHORAGE, AK 99503
(907) 339-9100 determinedesign.com

Copyright: Determine Design LLC has the exclusive right to reproduce, sell and assign, defendes works type, design practice.

Drawn: Daniel Clift
Date: 9/4/18
Time: 1:26 PM

STATE OF ALASKA — DANIEL H. CLIFT — 14104 — REGISTERED PROFESSIONAL ENGINEER

PROJECT TITLE: AMCO DIAGRAMS
PREPARED FOR: AK FROSTED FLOWERS, LLC
ADDRESS: 495 W Sun. Cir. Wasilla, AK 99654

SHEET NUMBER: 3

AMCO DIAGRAMS

Received by AMCO 1.6.18

Diagram #4

PLAN LEGEND (AMCO - CULTIVATION)

- CULTIVATION (RESTRICTED ACCESS AREA) & Licensed premises
- LICENSEE LEGAL OWNERSHIP AREA
- INV. MARIJUANA INVENTORY
- M-S MARIJUANA STORAGE
- Q QUARANTINE AREA
- W-S WASTE STORAGE

NORTH

LICENSE #: 17952

DBA: ALASKA FROSTED FLOWERS, LLC

NOTE: USE HALF INDICATED SCALE FOR 11X17 DRAWINGS

Determine DESIGN LLC AECL1613
Determine
Drawn: Daniel Clift
Date: 9/4/18
Time: 1:26 PM

PROJECT TITLE: AMCO DIAGRAMS
PREPARED FOR: AK FF ED FLOWERS, LLC
ADDRESS: 495 W Sunflo Cir. Wasilla, AK 99654

SHEET NUMBER: 4

AMCO DIAGRAMS