Alcohol and Marijuana Control Office
550 W 7th Avenue, Suite 1600
Anchorage, AK 99501
marijuana.licensing@alaska.gov
https://www.commerce.alaska.gov/web/amco
Phone: 907.269.0350

Alaska Marijuana Control Board

Form MJ-02: Premises Diagram

What is this form?

A detailed diagram of the proposed licensed premises is required for all marijuana establishment license applications, per 3 AAC 306.020(b)(8). **All areas designated as the licensed premises of a single license must be contiguous.**

What must be submitted with this form?

Applicants must attach multiple diagrams to this form, including (as applicable):

- **Diagram 1:**
  a diagram showing only the licensed premises areas that will be ready to be **operational at the time of your preliminary inspection** and license issuance;

- **Diagram 2:**
  if different than Diagram 1, a diagram outlining **all areas for which the licensee has legal right of possession** (a valid lease or deed), and clearly showing those areas' relationship to the current proposed licensed premises *(details of any planned expansion areas do not need to be included; a complete copy of Form MJ-14: Licensed Premises Diagram Change must be submitted and approved before any planned expansion area may be added to the licensed premises);*

- **Diagram 3:**
  a **site plan or as-built of the entire lot**, showing all structures on the property and clearly indicating which area(s) will be part of the licensed premises;

- **Diagram 4:**
  an **aerial photo of the entire lot and surrounding lots**, showing a view of the entire property and surrounding properties, and clearly indicating which area(s) will be part of the licensed premises *(this can be obtained from sources like Google Earth)*; and

- **Diagram 5:**
  a diagram of the **entire building in which the licensed premises is located**, clearly distinguishing the licensed premises from unlicensed areas and/or premises of other licenses within the building. If your proposed licensed premises is located within a building or building complex that contains multiple business and/or tenants, please provide the addresses and/or suite numbers of the other businesses and/or tenants *(a separate diagram is not required for an establishment that is designating the entire building as a single licensed premises)*.

This form, and all necessary diagrams that meet the requirements on Page 2 of this form, must be completed and submitted to AMCO's main office before any new or transfer license application will be considered complete.

Section 1 – Establishment Information

Enter information for the business seeking to be licensed, as identified on the license application.

Licensee:	Alaskan Grown Products, LLC	**MJ License #:**		17764	
License Type:	Retail Marijuana Store				
Doing Business As:	ALASKAN GROWN CANNABIS				
Premises Address:	585A 3rd Ave				
City:	Kotzebue	**State:**	Alaska	**ZIP:**	99752

AMCO Received 11/28/2018

Alaska Marijuana Control Board

Form MJ-02: Premises Diagram

Section 2 – Required Information

For your security, do not include locations of security cameras, motion detectors, panic buttons, and other security devices.

The following details must be included in all diagrams:

- ☐ License number and DBA
- ☐ Legend or key
- ☐ Color coding
- ☐ Dimensions
- ☐ Labels
- ☐ True north arrow

The following additional details must be included in Diagram 1:

- ☐ Surveillance room
- ☐ Restricted access areas
- ☐ Storage areas
- ☐ Entrances, exits, and windows
- ☐ Walls, partitions, and counters
- ☐ Any other areas that must be labeled for specific license types

The following additional details must be included in Diagram 2:

- ☐ Areas of ingress and egress
- ☐ Entrances and exits
- ☐ Walls and partitions

The following additional details must be included in Diagrams 3 and 4:

- ☐ Areas of ingress and egress
- ☐ Cross streets and points of reference

The following additional details must be included in Diagram 5:

- ☐ Areas of ingress and egress
- ☐ Entrances and exits
- ☐ Walls and partitions
- ☐ Cross streets and points of reference

I declare under penalty of unsworn falsification that I have attached all necessary diagrams that meet the above requirements, and that this form, including all accompanying schedules, statements, and depictions is true, correct, and complete.

Signature of licensee

Kelly Peacock

Printed name of licensee

VALERIE MASTOLIER
Notary Public
State of Alaska
My Commission Expires Jun 7, 2022

Notary Public in and for the State of Alaska

My commission expires: 6/7/22

Subscribed and sworn to before me this 24 day of July, 2018.

AMCO Received 11/28/2018

Alaskan Grown Cannabis

Kotzebue Retail
license #17764

= Licensed Premises
= Restricted Access

= hot water line
= cold water line

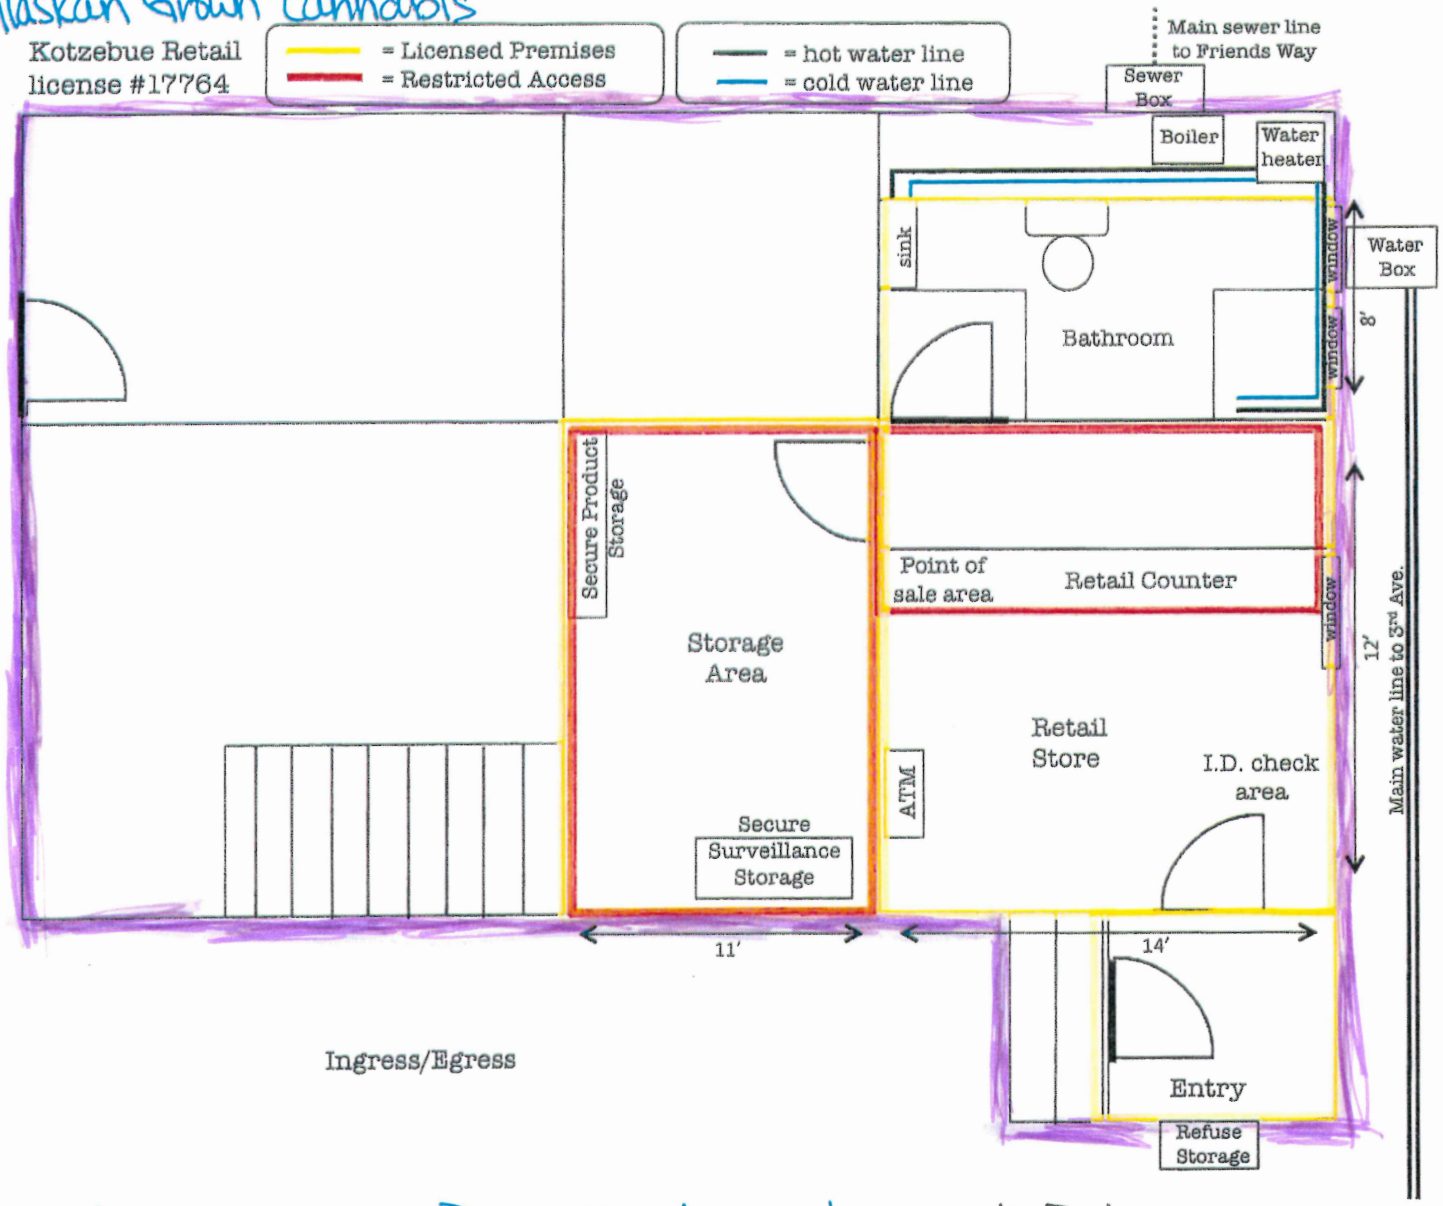

= indicates area licensee has sole right to possess but is unlicensed area, currently vacant but will be used as living quarters for Retail Manager

Diagram 1 and 2.1 & 5.1

AMCO Received 11/28/2018

AMCO Received 11/28/2018

Alaskan Grown Cannabis
License # 17764

Kotzebue Retail
license #17764

= Licensed Premises
= Restricted Access

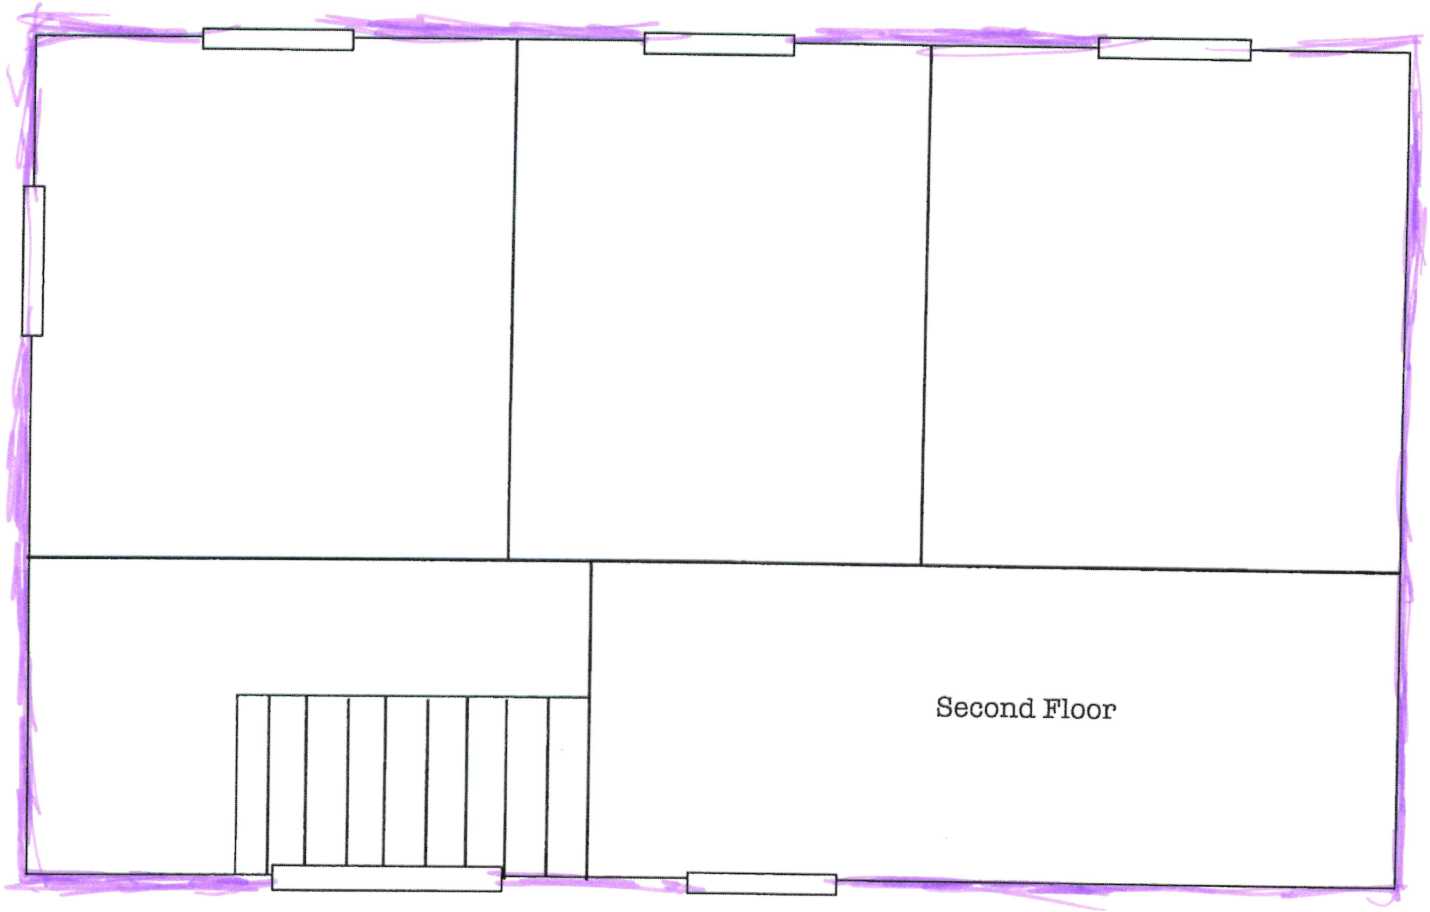

= Area Licensee has sole right to possess -nonLicensed Area Living quarters for Retail Store manager

Diagram 2.2 5.2

AMCO Received 11/28/2018

CITY OF KOTZEBUE
AS-BUILT DRAWING

OWNER: Bernhardt Savok

OCCUPANT: Bernhardt Savok

HOUSE LOCATION:

CITY HOUSE NO: 585

LOT: _____

BLOCK: _____

SUBDIVISION: _____

EXISTING FACILITIES:

YES

3/4" WATER SERVICE LINE (_____)..... ✓

4" SEWER SERVICE LINE (_____)..... _____

SERVICE LINE HEAT TAPE..... _____

DATE AS-BUILT COMPLETED:

SERVICE LINE REFERENCES:

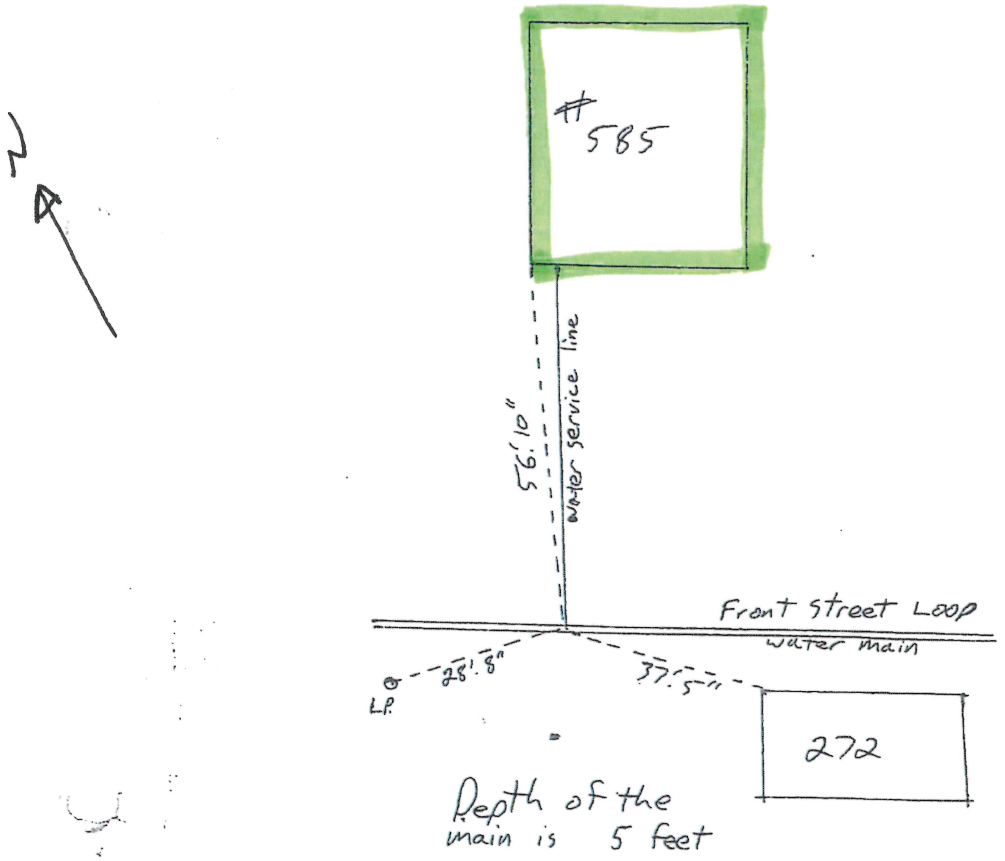

Depth of the main is 5 feet

Building that houses licensed premises

Alaskan Grown Cannabi
License #17764

Diagram 3

AMCO Received 11/28/2018

AS-BUILT DRAWING

OWNER: Bernie Savok

OCCUPANT: Same

HOUSE LOCATION:

LOT: 585

CITY REFERANCE NO: 585

BLOCK:

SUBDIVISION:

EXISTING FACILITIES:

	YES
3/4" Water Service Line (Copper)	
4" Sewer Service Line (PVC)	
Kitchen Sink	
Lavatory	
Toilet	
Bathtub	
Shower	
Service Line Heat Tape	

DATE COMPLETED: 10-8-92

SERVICE LINE REFERENCES:

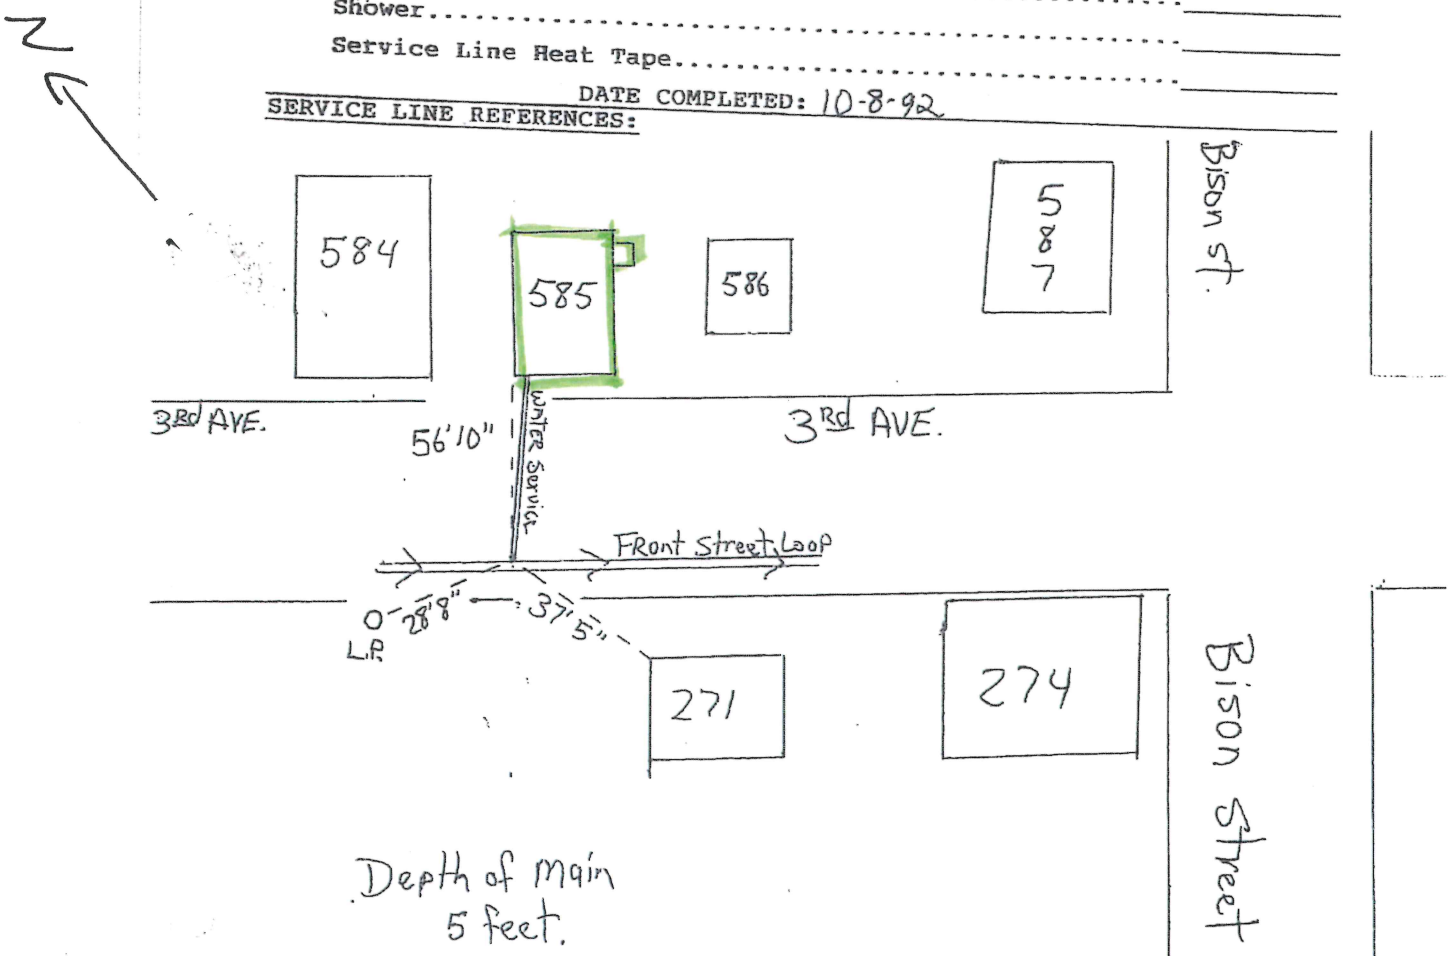

Depth of main
5 feet.

Building that houses
- licensed premises

Alaskan Grown Cannabis
License #17764

Diagram 4 & 5.3

AMCO Received 11/28/2018

N

Diagram #4 – this image is as good as Google earth gets for this Remote Location

Alaska Grown Cannabis # 17764

AMCO Received 11/28/2018