Alcohol and Marijuana Control Office
550 W 7th Avenue, Suite 1600
Anchorage, AK 99501
marijuana.licensing@alaska.gov
https://www.commerce.alaska.gov/web/amco
Phone: 907.269.0350

Alaska Marijuana Control Board

Form MJ-02: Premises Diagram

What is this form?

A detailed diagram of the proposed licensed premises is required for all marijuana establishment license applications, per 3 AAC 306.020(b)(8). **All areas designated as the licensed premises of a single license must be contiguous.** **All diagrams must have the licensed premises area labeled, and outlined or shaded as appropriate.**

What must be submitted with this form?

Applicants must attach multiple diagrams to this form, including (as applicable):

- **Diagram 1:**
  a diagram showing only the licensed premises areas that will be ready to be **operational at the time of your preliminary inspection** and license issuance;

- **Diagram 2:**
  if different than Diagram 1, a diagram outlining **all areas for which the licensee has legal right of possession** (a valid lease or deed), and clearly showing those areas' relationship to the current proposed licensed premises *(details of any planned expansion areas do not need to be included; a complete copy of Form MJ-14: Licensed Premises Diagram Change must be submitted and approved before any planned expansion area may be added to the licensed premises);*

- **Diagram 3:**
  a **site plan or as-built of the entire lot**, showing all structures on the property and clearly indicating which area(s) will be part of the licensed premises;

- **Diagram 4:**
  an **aerial photo of the entire lot and surrounding lots**, showing a view of the entire property and surrounding properties, and clearly indicating which area(s) will be part of the licensed premises *(this can be obtained from sources like Google Earth)*; and

- **Diagram 5:**
  a diagram of the **entire building in which the licensed premises is located**, clearly distinguishing the licensed premises from unlicensed areas and/or premises of other licenses within the building. If your proposed licensed premises is located within a building or building complex that contains multiple business and/or tenants, please provide the addresses and/or suite numbers of the other businesses and/or tenants *(a separate diagram is not required for an establishment that is designating the entire building as a single licensed premises)*.

This form, and all necessary diagrams that meet the requirements on Page 2 of this form, must be completed and submitted to AMCO's main office before any new or transfer license application will be considered complete.

Section 1 – Establishment Information

Enter information for the business seeking to be licensed, as identified on the license application.

Licensee:	Enlighten Alaska Greenery, LLC	**MJ License #:**	21551		
License Type:	Standard Marijuana Cultivation Facility				
Doing Business As:	Enlighten Alaska Greenery, LLC				
Premises Address:	524 E 48th Ave, 1B				
City:	Anchorage	**State:**	Alaska	**ZIP:**	99507

Received by AMCO 10/8/19

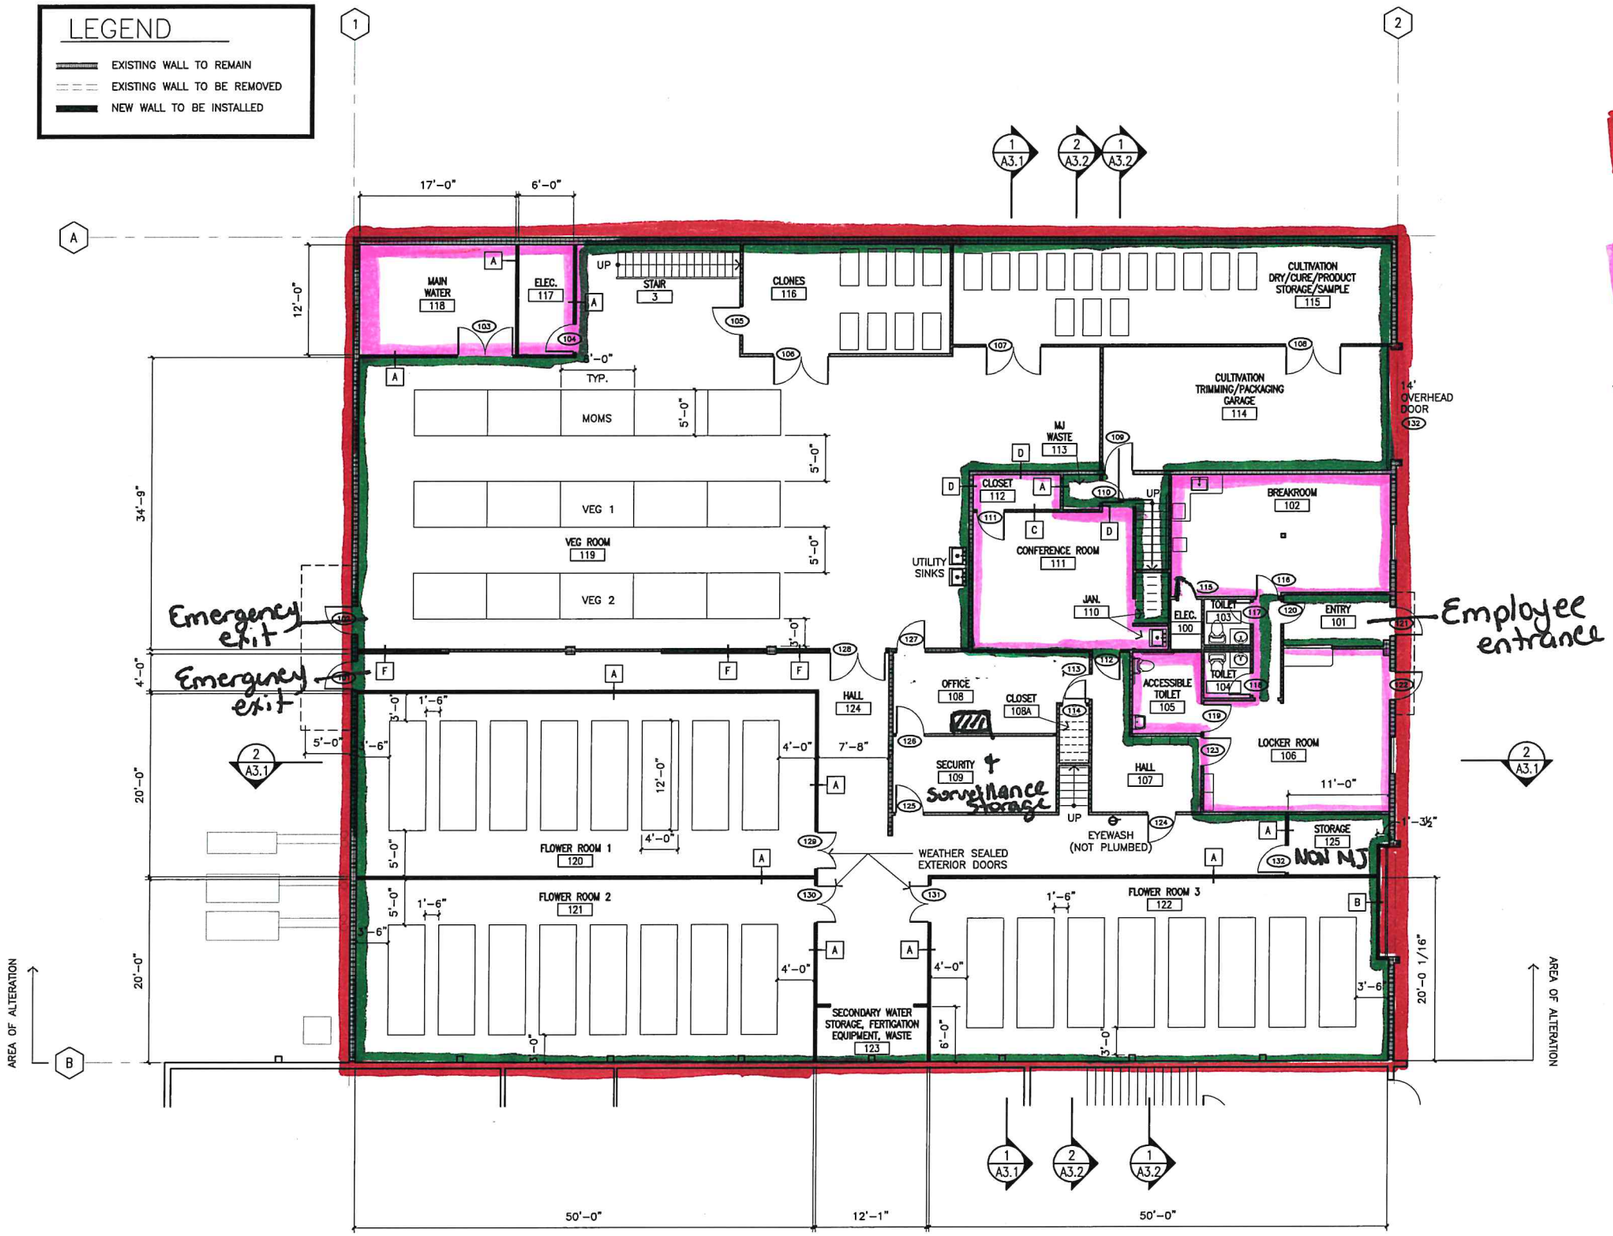

- proposed Licensed Premises/ 1st Floor Right to possession.
- unrestricted access areas
- restricted access areas.....
- 6 month Business Record storage

Enlighten Alaska Greenery, LLC
License # 21551
Diagrams 1 + 2

1 FIRST FLOOR PLAN
SCALE: 1/8" = 1'-0"

North

CHECK PRINT
10.02.2019

STATE OF ALASKA 49TH NOT FOR CONSTRUCTION Marco A. Zaccaro No. 10531 REGISTERED PROFESSIONAL ARCHITECT

ZARCHITECTS
commercial · planning · interiors · residential

ENLIGHTEN WAREHOUSE
524 E. 48TH AVE., ANCHORAGE, ALASKA

DESIGN DOCUMENTS

FIRST FLOOR PLAN

SUBMITTAL: XX.XX.XX
DRAWN BY: ET
CHECKED BY: MAZ
REVISIONS:

JOB NO. 19-18
COPYRIGHT 2019

A1.1

Received by AMCO 10/8/19

Diagram 3 & 5.1

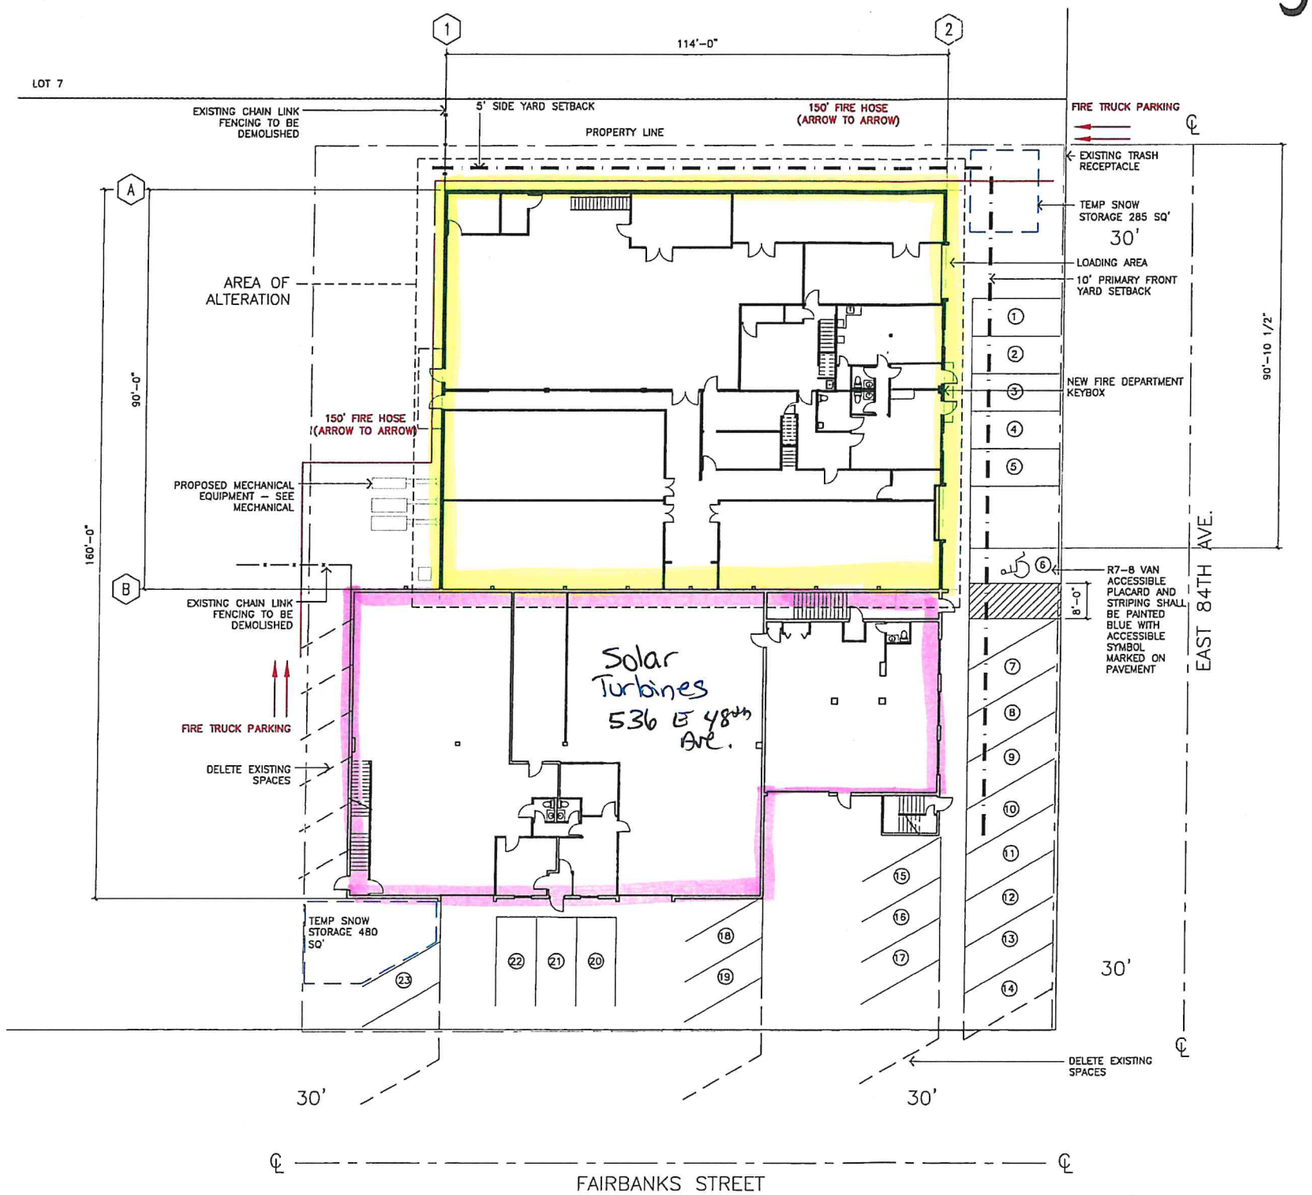

PARKING FOR OCCUPIED AREA PER 21.07.090C

MARIJUANA CULTIVATION (1 SPACE PER 1000 SF) / 10,473 SF = 10.5 SPACES

MARIJUANA MANUFACTURING (1 SPACE PER 400 SF) / 556 SF = 1.4 SPACES

12.8 SPACES

JOINT PARKING FOR ADJOINING SPACE

WAREHOUSE (1 SPACE PER 1000 SF) / 8599 SF = 8.6 SPACES

OFFICE (1 SPACE PER 350 SF) / 3606 SF = 10.3 SPACES

APARTMENT (1 SPACE UNIT) / 1365 SF = 1 SPACE

19.9 SPACES

33 SPACES TOTAL REQUIRED

40 SPACES ALLOWED PER NON CONFORMING DETERMINATION

- proposed Licensed Premises

- Neighboring Tenant (solar Turbines)

Enlighten Extractions, LLC
License # 21552.

1 SITE PLAN
SCALE: 1/16" = 1'-0"

North

95% COORDINATION SET
09.27.2019

STATE OF ALASKA 49TH
NOT FOR CONSTRUCTION
Mario A. Zaccaro No. 10531
REGISTERED PROFESSIONAL ARCHITECT

ZARCHITECTS
commercial • planning • interiors • residential

ENLIGHTEN WAREHOUSE
524 E. 48TH AVE., ANCHORAGE, ALASKA

DESIGN DOCUMENTS

SITE PLAN

SUBMITTAL: XX.XX.XX
DRAWN BY: ET
CHECKED BY: MAZ
REVISIONS:

JOB NO. 19-18
COPYRIGHT 2019

A0.3

AMCO Received 10/22/2019

Diagram 1.1

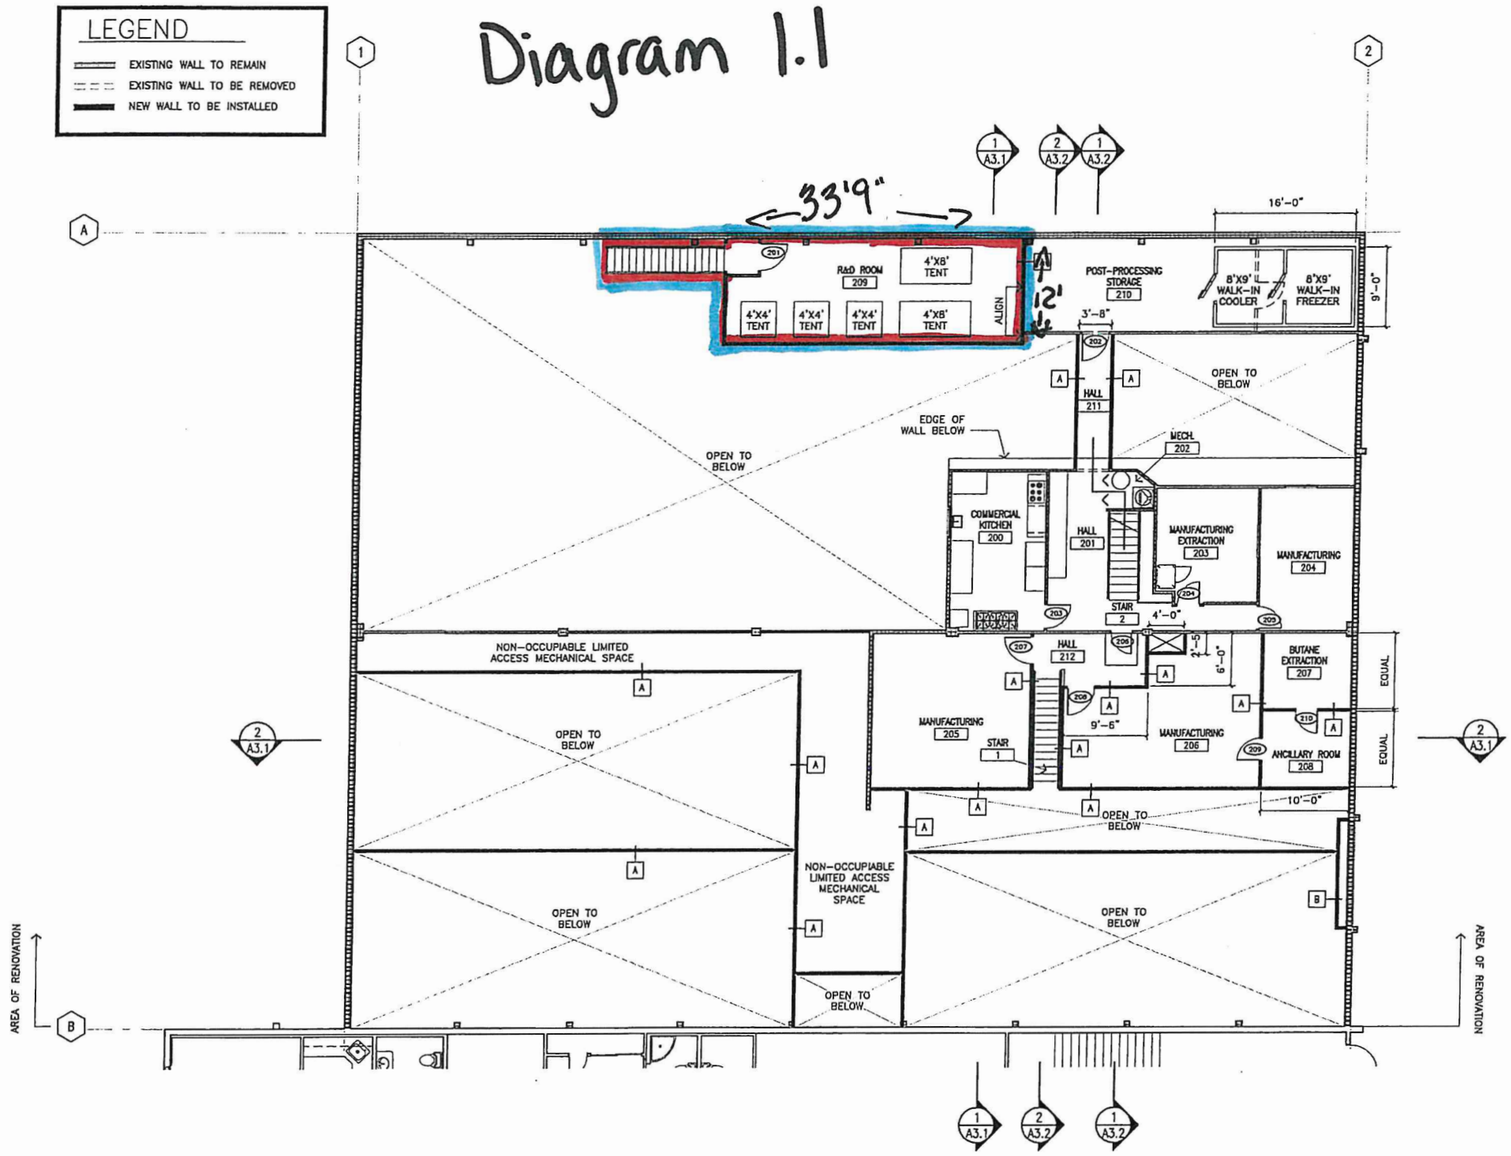

D - Restricted Access AREA

D - PROPOSED LICENSED PREMISES

Enlighten Alaska Greenery, LLC
License #21551

1 SECOND FLOOR PLAN
SCALE: 1/8" = 1'-0"

North

CHECK PRINT
10.02.2019

STATE OF ALASKA 49TH NOT FOR CONSTRUCTION Marco A. Zaccaro No. 10531 REGISTERED PROFESSIONAL ARCHITECT

ZARCHITECTS
commercial • planning • interiors • residential

ENLIGHTEN WAREHOUSE
524 E. 48TH AVE., ANCHORAGE, ALASKA

DESIGN DOCUMENTS

SECOND FLOOR PLAN

SUBMITTAL: XX.XX.XX
DRAWN BY: ET
CHECKED BY: MAZ
REVISIONS:

JOB NO. 19-18
COPYRIGHT 2019

A1.2

AMCO Received 10/22/2019

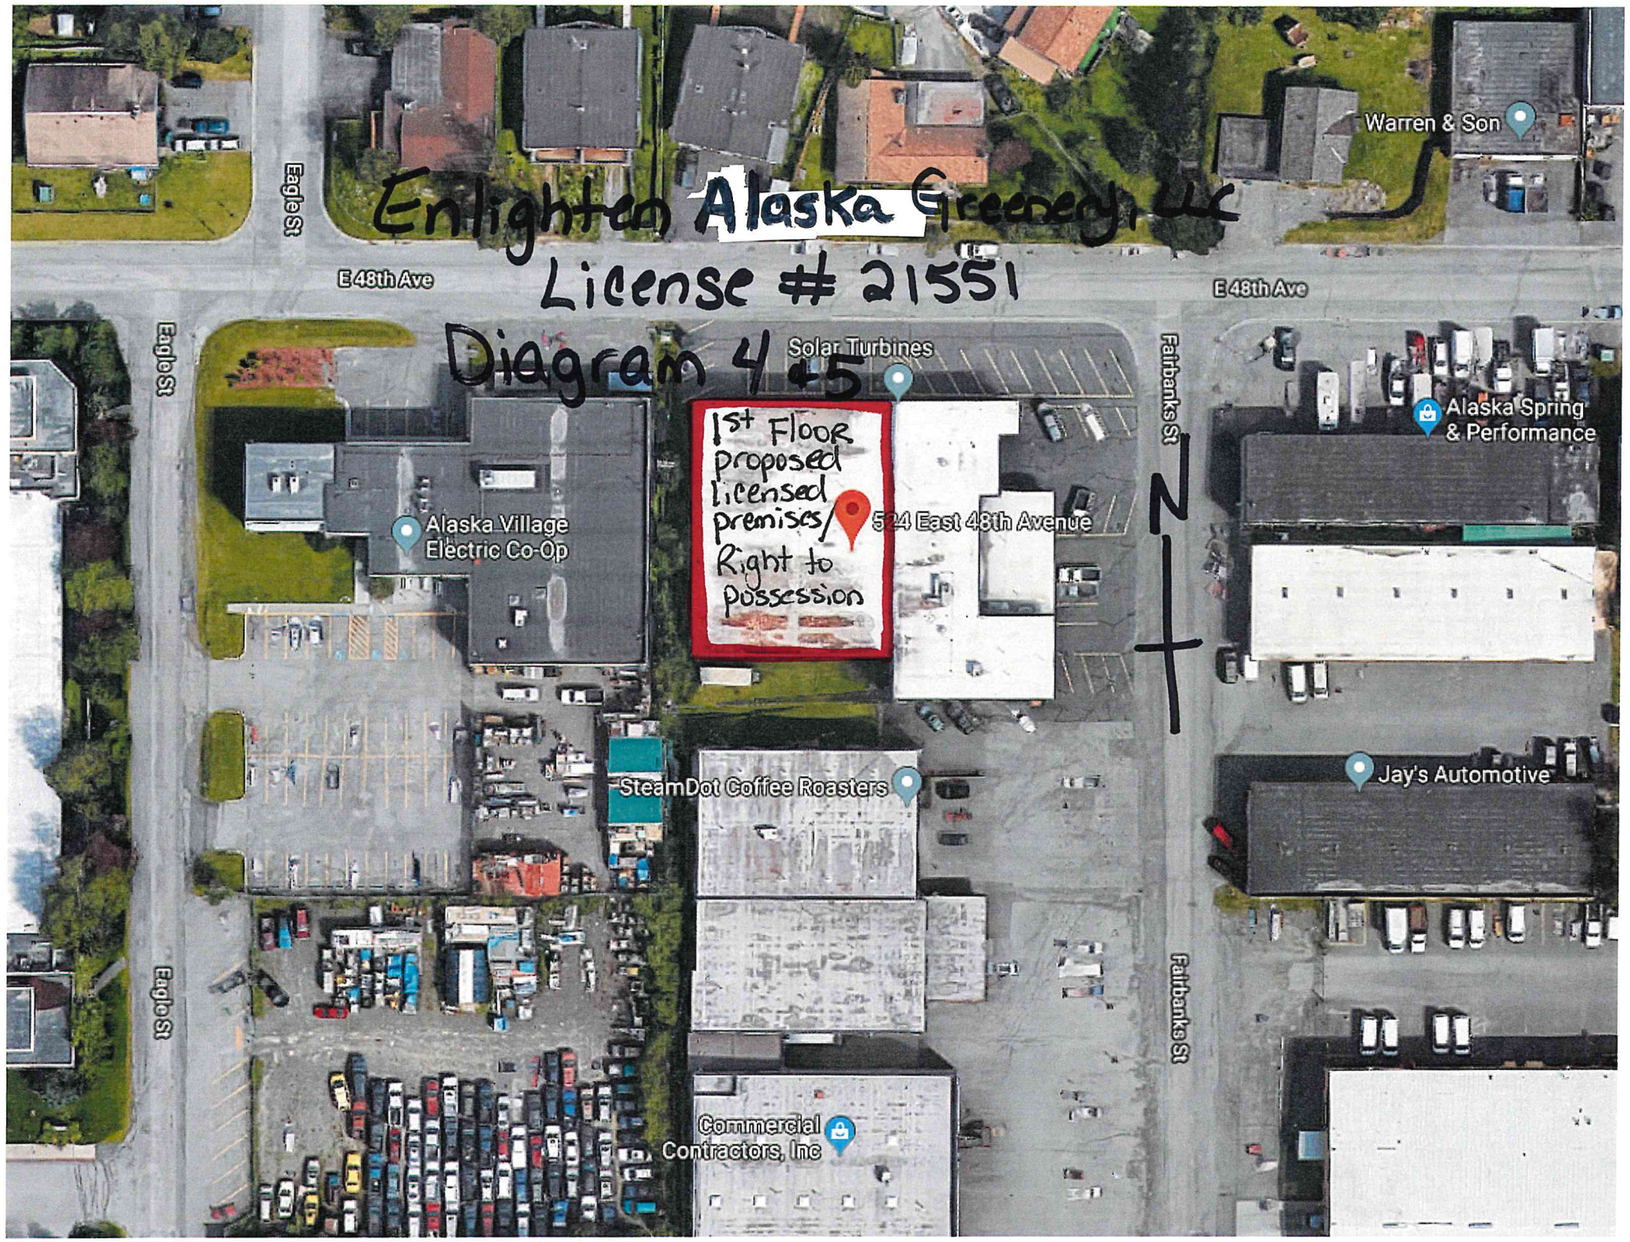

Received by AMCO 10/8/19

Alaska Marijuana Control Board

Form MJ-02: Premises Diagram

Section 2 – Required Information

For your security, do not include locations of security cameras, motion detectors, panic buttons, and other security devices.
Items marked with a double asterisks (**) are only required for those retail marijuana establishments that are also applying for an onsite consumption endorsement.

The following details must be included in all diagrams:

- ☐ License number and DBA
- ☐ Legend or key
- ☐ Color coding
- ☐ Licensed Premises Area Labeled and Shaded, or Outlined as appropriate
- ☐ Dimensions
- ☐ Labels
- ☐ True north arrow

The following additional details must be included in Diagram 1:

- ☐ Surveillance room
- ☐ Restricted access areas
- ☐ Storage areas
- ☐ Entrances, exits, and windows
- ☐ Walls, partitions, and counters
- ☐ Any other areas that must be labeled for specific license or endorsement types
- ☐ ** Serving area(s)
- ☐ **Employee monitoring area(s)
- ☐ **Ventilation exhaust points, if applicable

The following additional details must be included in Diagram 2:

- ☐ Areas of ingress and egress
- ☐ Entrances and exits
- ☐ Walls and partitions

The following additional details must be included in Diagrams 3 and 4:

- ☐ Areas of ingress and egress
- ☐ Cross streets and points of reference

The following additional details must be included in Diagram 5:

- ☐ Areas of ingress and egress
- ☐ Entrances and exits
- ☐ Walls and partitions
- ☐ Cross streets and points of reference

I declare under penalty of unsworn falsification that I have attached all necessary diagrams that meet the above requirements, and that this form, including all accompanying schedules, statements, and depictions is true, correct, and complete.

Signature of licensee

Jane Stinson
Printed name of licensee

VALERIE MASTOLIER
Notary Public
State of Alaska
My Commission Expires Jun 7, 2022

Notary Public in and for the State of Alaska

My commission expires: 4/7/22

Subscribed and sworn to before me this 2 day of August, 2019.

Received by AMCO 10/8/19