Alcohol and Marijuana Control Office
550 W 7th Avenue, Suite 1600
Anchorage, AK 99501
marijuana.licensing@alaska.gov
https://www.commerce.alaska.gov/web/amco
Phone: 907.269.0350

Alaska Marijuana Control Board

Form MJ-02: Premises Diagram

What is this form?

A detailed diagram of the proposed licensed premises is required for all marijuana establishment license applications, per 3 AAC 306.020(b)(8). **All areas designated as the licensed premises of a single license must be contiguous.**

What must be submitted with this form?

Applicants must attach multiple diagrams to this form, including (as applicable):

- **Diagram 1:**
  a diagram showing only the licensed premises areas that will be ready to be **operational at the time of your preliminary inspection** and license issuance;

- **Diagram 2:**
  if different than Diagram 1, a diagram outlining **all areas for which the licensee has legal right of possession** (a valid lease or deed), and clearly showing those areas' relationship to the current proposed licensed premises *(details of any planned expansion areas do not need to be included; a complete copy of Form MJ-14: Licensed Premises Diagram Change must be submitted and approved before any planned expansion area may be added to the licensed premises);*

- **Diagram 3:**
  a **site plan or as-built of the entire lot**, showing all structures on the property and clearly indicating which area(s) will be part of the licensed premises;

- **Diagram 4:**
  an **aerial photo of the entire lot and surrounding lots**, showing a view of the entire property and surrounding properties, and clearly indicating which area(s) will be part of the licensed premises *(this can be obtained from sources like Google Earth)*; and

- **Diagram 5:**
  a diagram of the **entire building in which the licensed premises is located**, clearly distinguishing the licensed premises from unlicensed areas and/or premises of other licenses within the building. If your proposed licensed premises is located within a building or building complex that contains multiple business and/or tenants, please provide the addresses and/or suite numbers of the other businesses and/or tenants *(a separate diagram is not required for an establishment that is designating the entire building as a single licensed premises)*.

This form, and all necessary diagrams that meet the requirements on Page 2 of this form, must be completed and submitted to AMCO's main office before any new or transfer license application will be considered complete.

Section 1 – Establishment Information

Enter information for the business seeking to be licensed, as identified on the license application.

Licensee:	Shotnine, LLC	**MJ License #:**		15016	
License Type:	Retail Marijuana Store				
Doing Business As:	The Vault Cannabis				
Premises Address:	1133 E. 68th Ave.				
City:	Anchorage	**State:**	Alaska	**ZIP:**	99518

Received by AMCO 1/24/19

Alaska Marijuana Control Board

Form MJ-02: Premises Diagram

Section 2 – Required Information

For your security, do not include locations of security cameras, motion detectors, panic buttons, and other security devices.

The following details must be included in all diagrams:

- ☐ License number and DBA
- ☐ Legend or key
- ☐ Color coding
- ☐ Dimensions
- ☐ Labels
- ☐ True north arrow

The following additional details must be included in Diagram 1:

- ☐ Surveillance room
- ☐ Restricted access areas
- ☐ Storage areas
- ☐ Entrances, exits, and windows
- ☐ Walls, partitions, and counters
- ☐ Any other areas that must be labeled for specific license types

The following additional details must be included in Diagram 2:

- ☐ Areas of ingress and egress
- ☐ Entrances and exits
- ☐ Walls and partitions

The following additional details must be included in Diagrams 3 and 4:

- ☐ Areas of ingress and egress
- ☐ Cross streets and points of reference

The following additional details must be included in Diagram 5:

- ☐ Areas of ingress and egress
- ☐ Entrances and exits
- ☐ Walls and partitions
- ☐ Cross streets and points of reference

I declare under penalty of unsworn falsification that I have attached all necessary diagrams that meet the above requirements, and that this form, including all accompanying schedules, statements, and depictions is true, correct, and complete.

Signature of licensee

Noah Groskreutz

Printed name of licensee

VALERIE MASTOLIER
Notary Public
State of Alaska
My Commission Expires Jun 7, 2022

Notary Public in and for the State of Alaska

My commission expires: 6/7/22

Subscribed and sworn to before me this 17 day of September, 20 18

Received by AMCO 1/24/19

Diagram 1+2+ The Vault Cannabis
S #15016

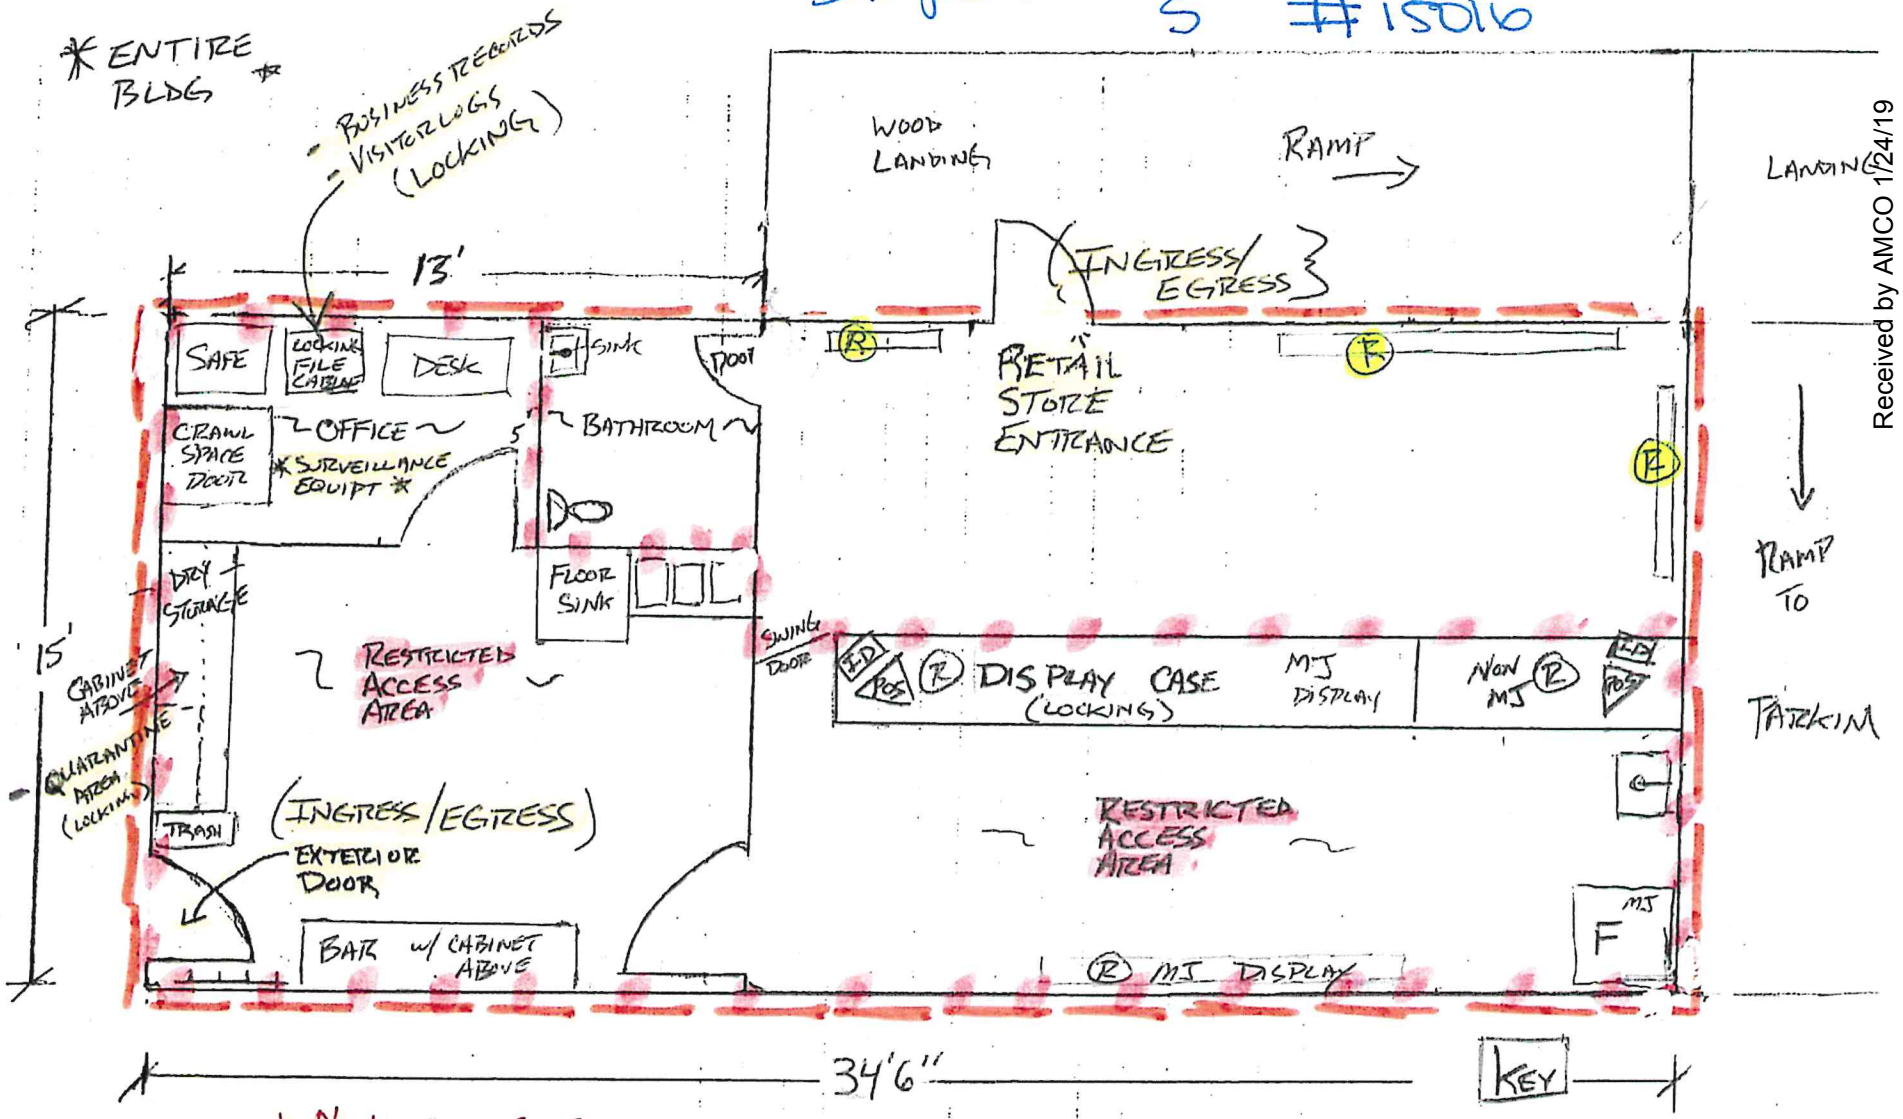

Received by AMCO 1/24/19

= licensed premises
The Vault Cannabis
#15016

Diagram 3

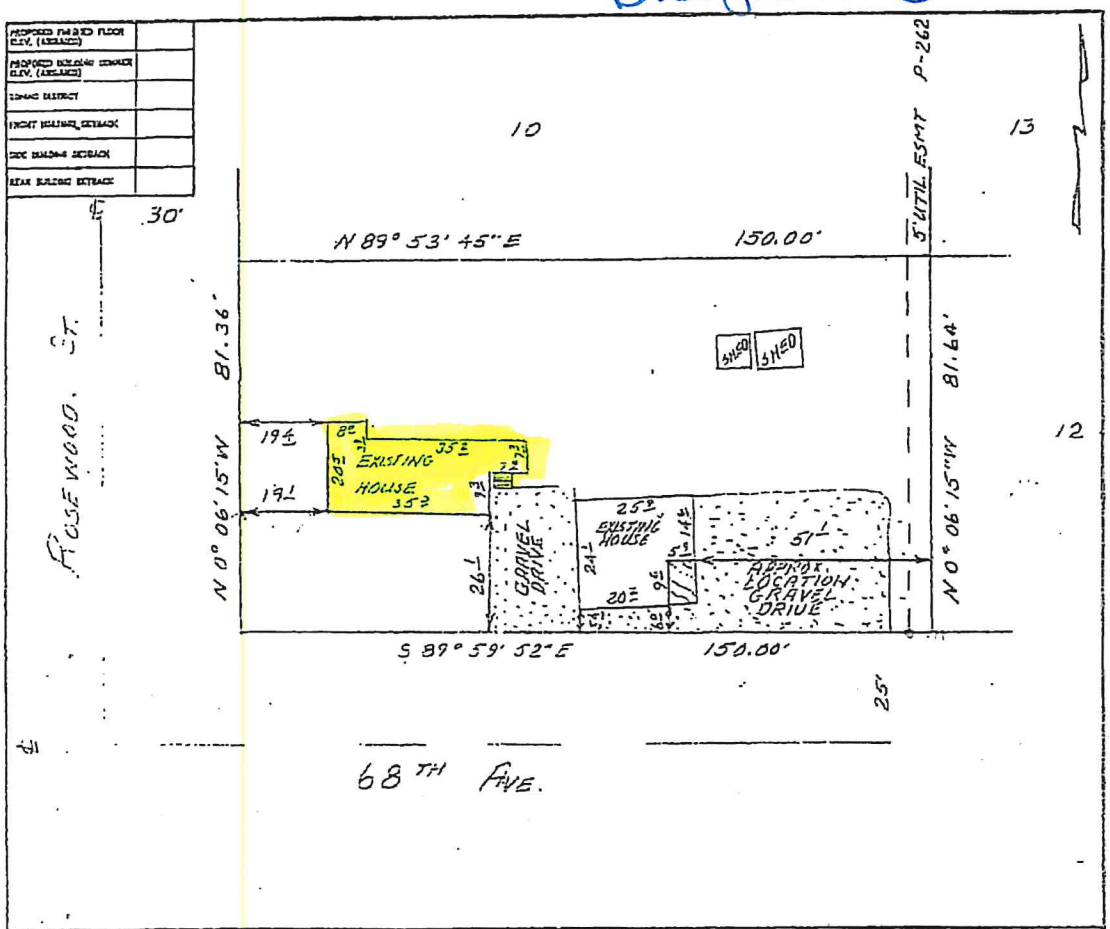

SURVEY CERTIFICATION

PLOT PLAN

I hereby certify that I have physically surveyed the lot drawn and described herein, and that I have found or established all of the lot corners as shown on the plan and to the best of my knowledge and belief, all dimensions have been measured true and correct.

FOUNDATION AS-BUILT

I, Robert E. Johns, Jr. hereby certify that I have performed an as-built survey of the foundation on this lot and that all the dimensions and information as shown hereon are true and no encroachments exist unless shown otherwise.

FINAL STRUCTURE AS-BUILT

I, Robert E. Johns, Jr. hereby certify that I have performed an as-built survey of the structure on this lot and that all the dimensions and information as shown hereon are true and no encroachments exist unless shown otherwise.

STATE OF ALASKA
49th
ROBERT E. JOHNS, JR.
4121-S
Registered Professional Land Surveyor

Prepared by
Robert E. Johns, Jr. & Assoc.
Professional Land Surveyors
642 E. 12 AVE.
ANCHORAGE, ALASKA 99501

Scale: 1" = 30'	Rec. Lot S.F.	Rec. Plat File No.
Date Surveyed: FEBRUARY 4, 2003	Drawn by: REJ	Checked by: MLJ
Date Drawn: FEBRUARY 4, 2003	Grid: 2032	W.O. 23019

Legal Description:
LOT 11, BLOCK D, MURRAY SUBDIVISION

SURVEY TYPE

- ☐ LOT SURVEY
- ☐ FOUNDATION AS-BUILT
- ☐ FINAL STRUCTURE AS-BUILT
- ☐ PLOT PLAN . . . AS-BUILT . . . LOT SURVEY . . . TOPOGRAPHY
- ☒ AS-BUILT . . . NO CORNERS SET ☐ RECERTIFICATION AS-BUILT . . . NO CORNERS SET

SYMBOLS

- SET REBAR
- FOUND REBAR
- (100.0) ASSUMED ELEV.
- EXISTING / PROPOSED DRAINAGE
- WOOD FENCE
- METAL FENCE
- ASPHALT
- CONCRETE
- WOOD DECK

PLOT PLANS & LOT SURVEYS

IT IS THE RESPONSIBILITY OF THE BUILDER OR OWNER, PRIOR TO CONSTRUCTION, TO VERIFY PROPOSED BUILDING GRADE RELATIVE TO FINISHED GRADE AND UTILITY CONNECTIONS AND TO DETERMINE THE EXISTENCE OF ANY EASEMENTS, COVENANTS OR RESTRICTIONS WHICH DO NOT APPEAR ON THE RECORDED SUBDIVISION PLAT.

NOTE:

ONLY THOSE IMPROVEMENTS ABOVE GROUND AND VISIBLE WILL BE SHOWN. FENCES, WELLS, SEPTIC CLEANOUTS, SIDEWALKS, DRIVEWAYS, ETC., ARE SHOWN IN THEIR APPROXIMATE LOCATION, ONLY. SNOW MAY PREVENT SOME IMPROVEMENTS FROM BEING SEEN AND LOCATED. ALL DISTANCES ARE RECORD UNLESS OTHERWISE NOTED.

UNDER NO CIRCUMSTANCES SHOULD AN AS-BUILT BE USED FOR CONSTRUCTION OR FOR ESTABLISHING BOUNDARY OR FENCE LINES. THE SURVEYOR TAKES RESPONSIBILITY FOR THE INITIAL TRANSACTION ONLY AND ASSUMES FINANCIAL LIABILITY ONLY FOR THE COST OF THE SURVEY. LISTED DISTANCES PREVAIL OVER SCALING. REPRODUCTION MAY CAUSE ERRORS IN SCALE.

Diagram 4
The vault cannabis
#15016

= licensed premises

Received by AMCO 1/24/19