Alcohol and Marijuana Control Office
550 W 7th Avenue, Suite 1600
Anchorage, AK 99501
marijuana.licensing@alaska.gov
https://www.commerce.alaska.gov/web/amco
Phone: 907.269.0350

Alaska Marijuana Control Board

Form MJ-02: Premises Diagram

What is this form?

A detailed diagram of the proposed licensed premises is required for all marijuana establishment license applications, per 3 AAC 306.020(b)(8). **All areas designated as the licensed premises of a single license must be contiguous.**

What must be submitted with this form?

Applicants must attach multiple diagrams to this form, including (as applicable):

- **Diagram 1:**
  a diagram showing only the licensed premises areas that will be ready to be **operational at the time of your preliminary inspection** and license issuance;

- **Diagram 2:**
  if different than Diagram 1, a diagram outlining **all areas for which the licensee has legal right of possession** (a valid lease or deed), and clearly showing those areas' relationship to the current proposed licensed premises *(details of any planned expansion areas do not need to be included; a complete copy of Form MJ-14: Licensed Premises Diagram Change must be submitted and approved before any planned expansion area may be added to the licensed premises);*

- **Diagram 3:**
  a **site plan or as-built of the entire lot**, showing all structures on the property and clearly indicating which area(s) will be part of the licensed premises;

- **Diagram 4:**
  an **aerial photo of the entire lot and surrounding lots**, showing a view of the entire property and surrounding properties, and clearly indicating which area(s) will be part of the licensed premises *(this can be obtained from sources like Google Earth)*; and

- **Diagram 5:**
  a diagram of the **entire building in which the licensed premises is located**, clearly distinguishing the licensed premises from unlicensed areas and/or premises of other licenses within the building. If your proposed licensed premises is located within a building or building complex that contains multiple business and/or tenants, please provide the addresses and/or suite numbers of the other businesses and/or tenants *(a separate diagram is not required for an establishment that is designating the entire building as a single licensed premises)*.

This form, and all necessary diagrams that meet the requirements on Page 2 of this form, must be completed and submitted to AMCO's main office before any new or transfer license application will be considered complete.

Section 1 – Establishment Information

Enter information for the business seeking to be licensed, as identified on the license application.

Licensee:	Andrew Sablon	**MJ License #:**	19658		
License Type:	Retail Marijuana Store				
Doing Business As:	DejaVu Cannabis Company				
Premises Address:	11676 W. Rezanof dr				
City:	Kodiak	**State:**	Alaska	**ZIP:**	99615

RECEIVED
JAN 31 2019
ALCOHOL & MARIJUANA CONTROL OFFICE

Alaska Marijuana Control Board

Form MJ-02: Premises Diagram

Section 2 – Required Information

For your security, do not include locations of security cameras, motion detectors, panic buttons, and other security devices.

The following details must be included in all diagrams:

- ☐ License number and DBA
- ☐ Legend or key
- ☐ Color coding
- ☐ Dimensions
- ☐ Labels
- ☐ True north arrow

The following additional details must be included in Diagram 1:

- ☐ Surveillance room
- ☐ Restricted access areas
- ☐ Storage areas
- ☐ Entrances, exits, and windows
- ☐ Walls, partitions, and counters
- ☐ Any other areas that must be labeled for specific license types

The following additional details must be included in Diagram 2:

- ☐ Areas of ingress and egress
- ☐ Entrances and exits
- ☐ Walls and partitions

The following additional details must be included in Diagrams 3 and 4:

- ☐ Areas of ingress and egress
- ☐ Cross streets and points of reference

The following additional details must be included in Diagram 5:

- ☐ Areas of ingress and egress
- ☐ Entrances and exits
- ☐ Walls and partitions
- ☐ Cross streets and points of reference

I declare under penalty of unsworn falsification that I have attached all necessary diagrams that meet the above requirements, and that this form, including all accompanying schedules, statements, and depictions is true, correct, and complete.

Signature of licensee

Andrew Sablon
Printed name of licensee

OFFICIAL SEAL
Brook Baldwin
Notary Public - State of Alaska

Notary Public in and for the State of Alaska

My commission expires: 10-26-19

Subscribed and sworn to before me this 22nd day of January, 2019.

License # 19658

RECEIVED
JAN 31 2019
ALCOHOL MARIJUANA CONTROL OFFICE

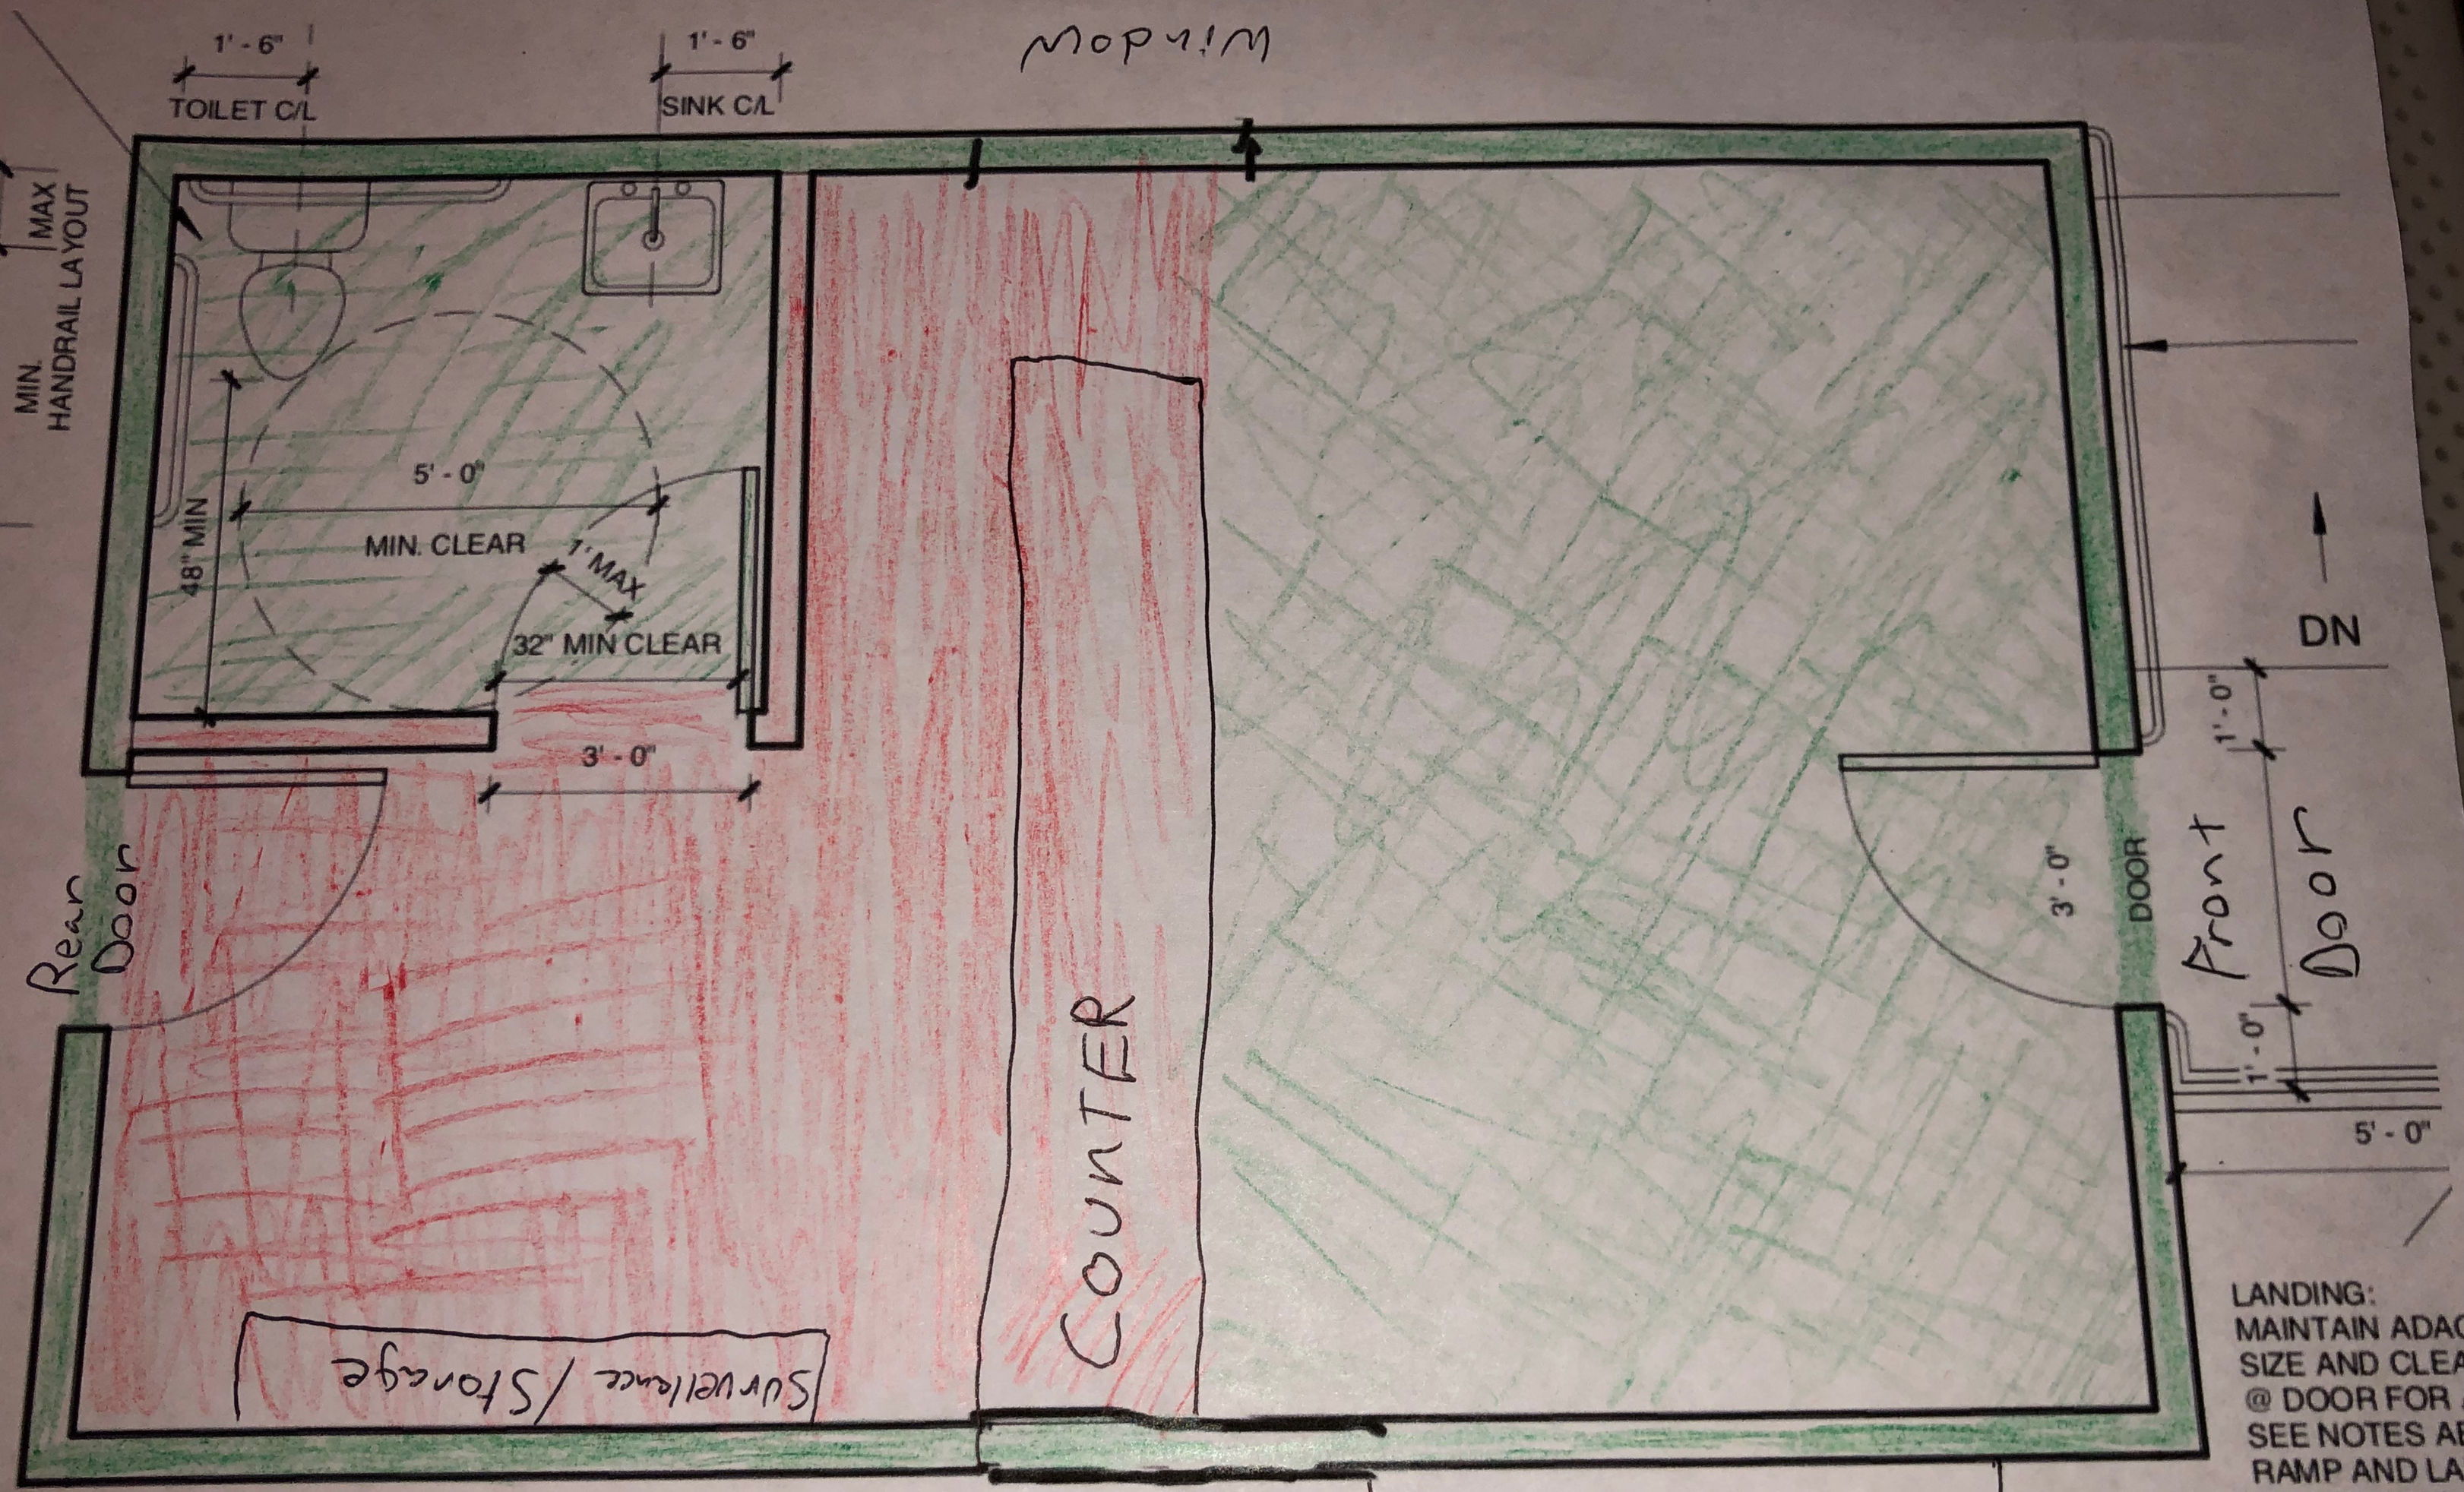

LANDING:
MAINTAIN ADAC
SIZE AND CLEAI
@ DOOR FOR A
SEE NOTES ABC
RAMP AND LAN
MAINTAIN ACCE
THRESHOLD AT
DOOR.

Dejavu Cannabis Company 19658

Diagram 1

Legend

= Licensed Premises

= Restricted Access

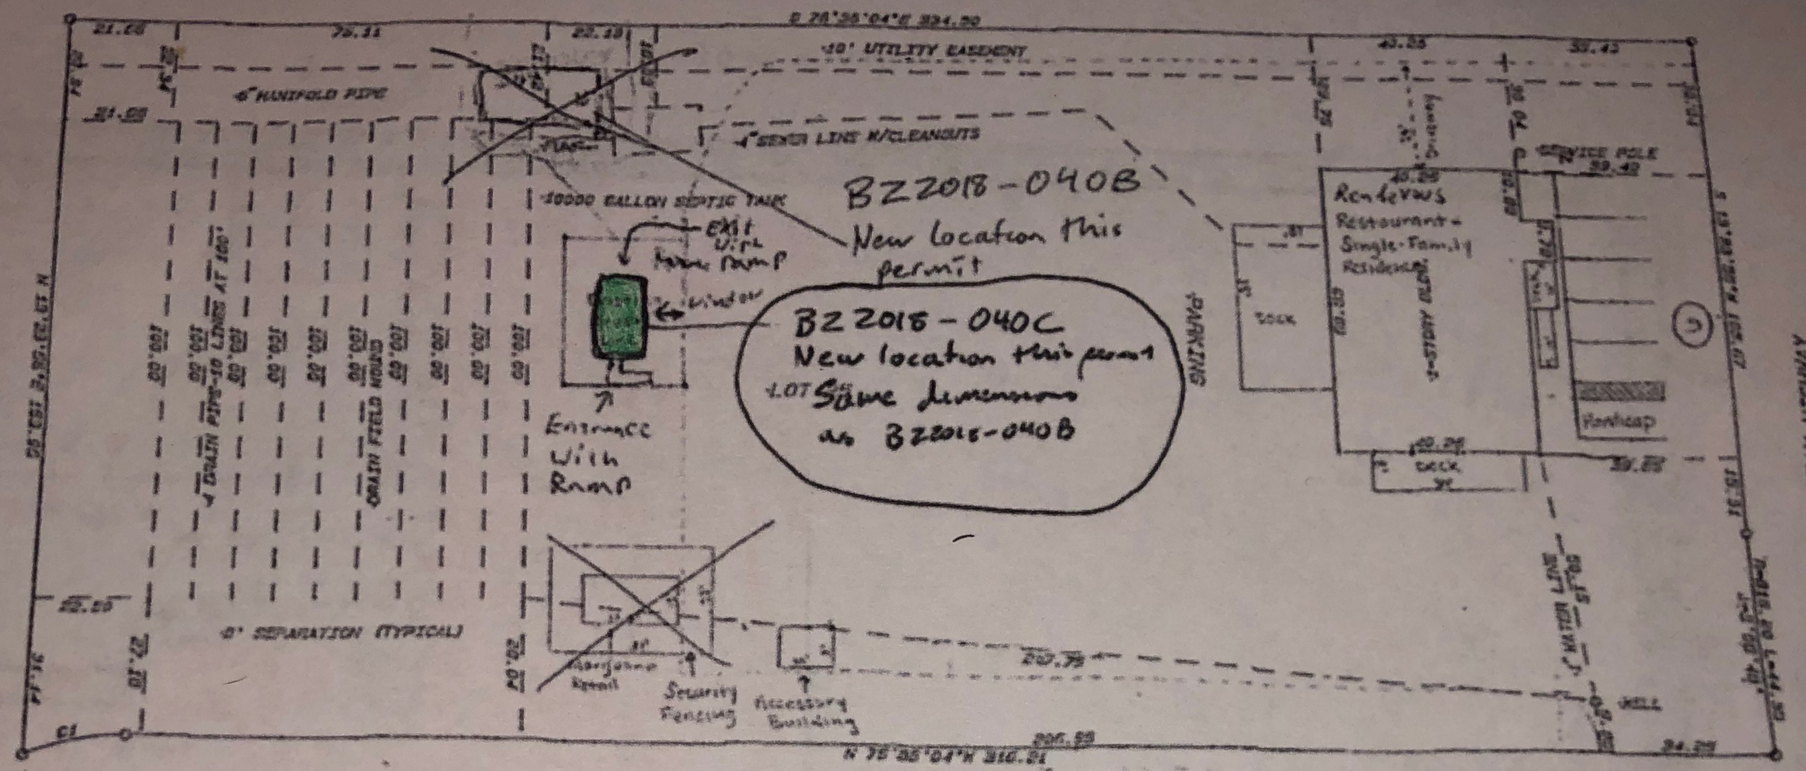

Δ=32 57'00"
R=30.00'
L=30.03'

WIDGEON CIRCLE

AS-BUILT ELEVATIONS

- 109.0 = TOP SOIL
- 106.0 = FABRIC
- 105.5 = DRAIN PIPE
- 104.5 = BOTTOM TRENCH
- 100.0 = WATER TABLE

NOTES

REFER TO SHEETS NO. 1994103-1 AND 1994103-2 BY ROLLAND A. JONES P.E. FOR DESIGN SPECIFICATIONS.

- 50 seats inside
- 12 seats outside
- 62 seats total
- 1 space per 3 seats
- 21 spaces for restaurant
- 3 spaces for SFR
- 3 spaces for proposed marijuana retail

27 spaces total (incl. 1 10'x30' loading space + 1

STATE OF ALASKA 49TH
R. L. TARRANT 1641-S
Registered Professional Land Surveyor

I hereby certify that I have surveyed the following described property:
Lot 25B, Russian Creek Alaska
Subdivision U.S.S. 2539
Plat # 80-18 Block-1,
and that the improvements situated thereon are within the property lines and do not overlap or encroach on the property lying adjacent thereto; that no improvements on property lying adjacent thereto encroach the premises in question and that there are no roadways, transmission lines or other visible easements on said property except as shown hereon.

Dated this 6TH day of Nov. 19 88

R. L. Tarrant
ROBERT L. TARRANT
Registered Land Surveyor

Scale: 1" = 30' | Drawn by: R.L.T. | Date: 11/06/88

Legend
Licensed Premises =

RECEIVED JAN 31 2019

#19658
DejaVu Cannabis Company
Diagram 3

Diagram
(4)
Dejavu
Cannabis
Company
19058#

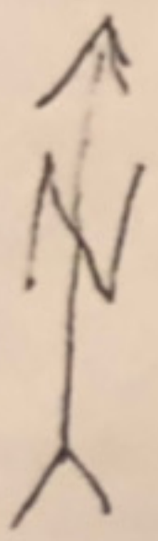

Licensed
Premises =

Legend

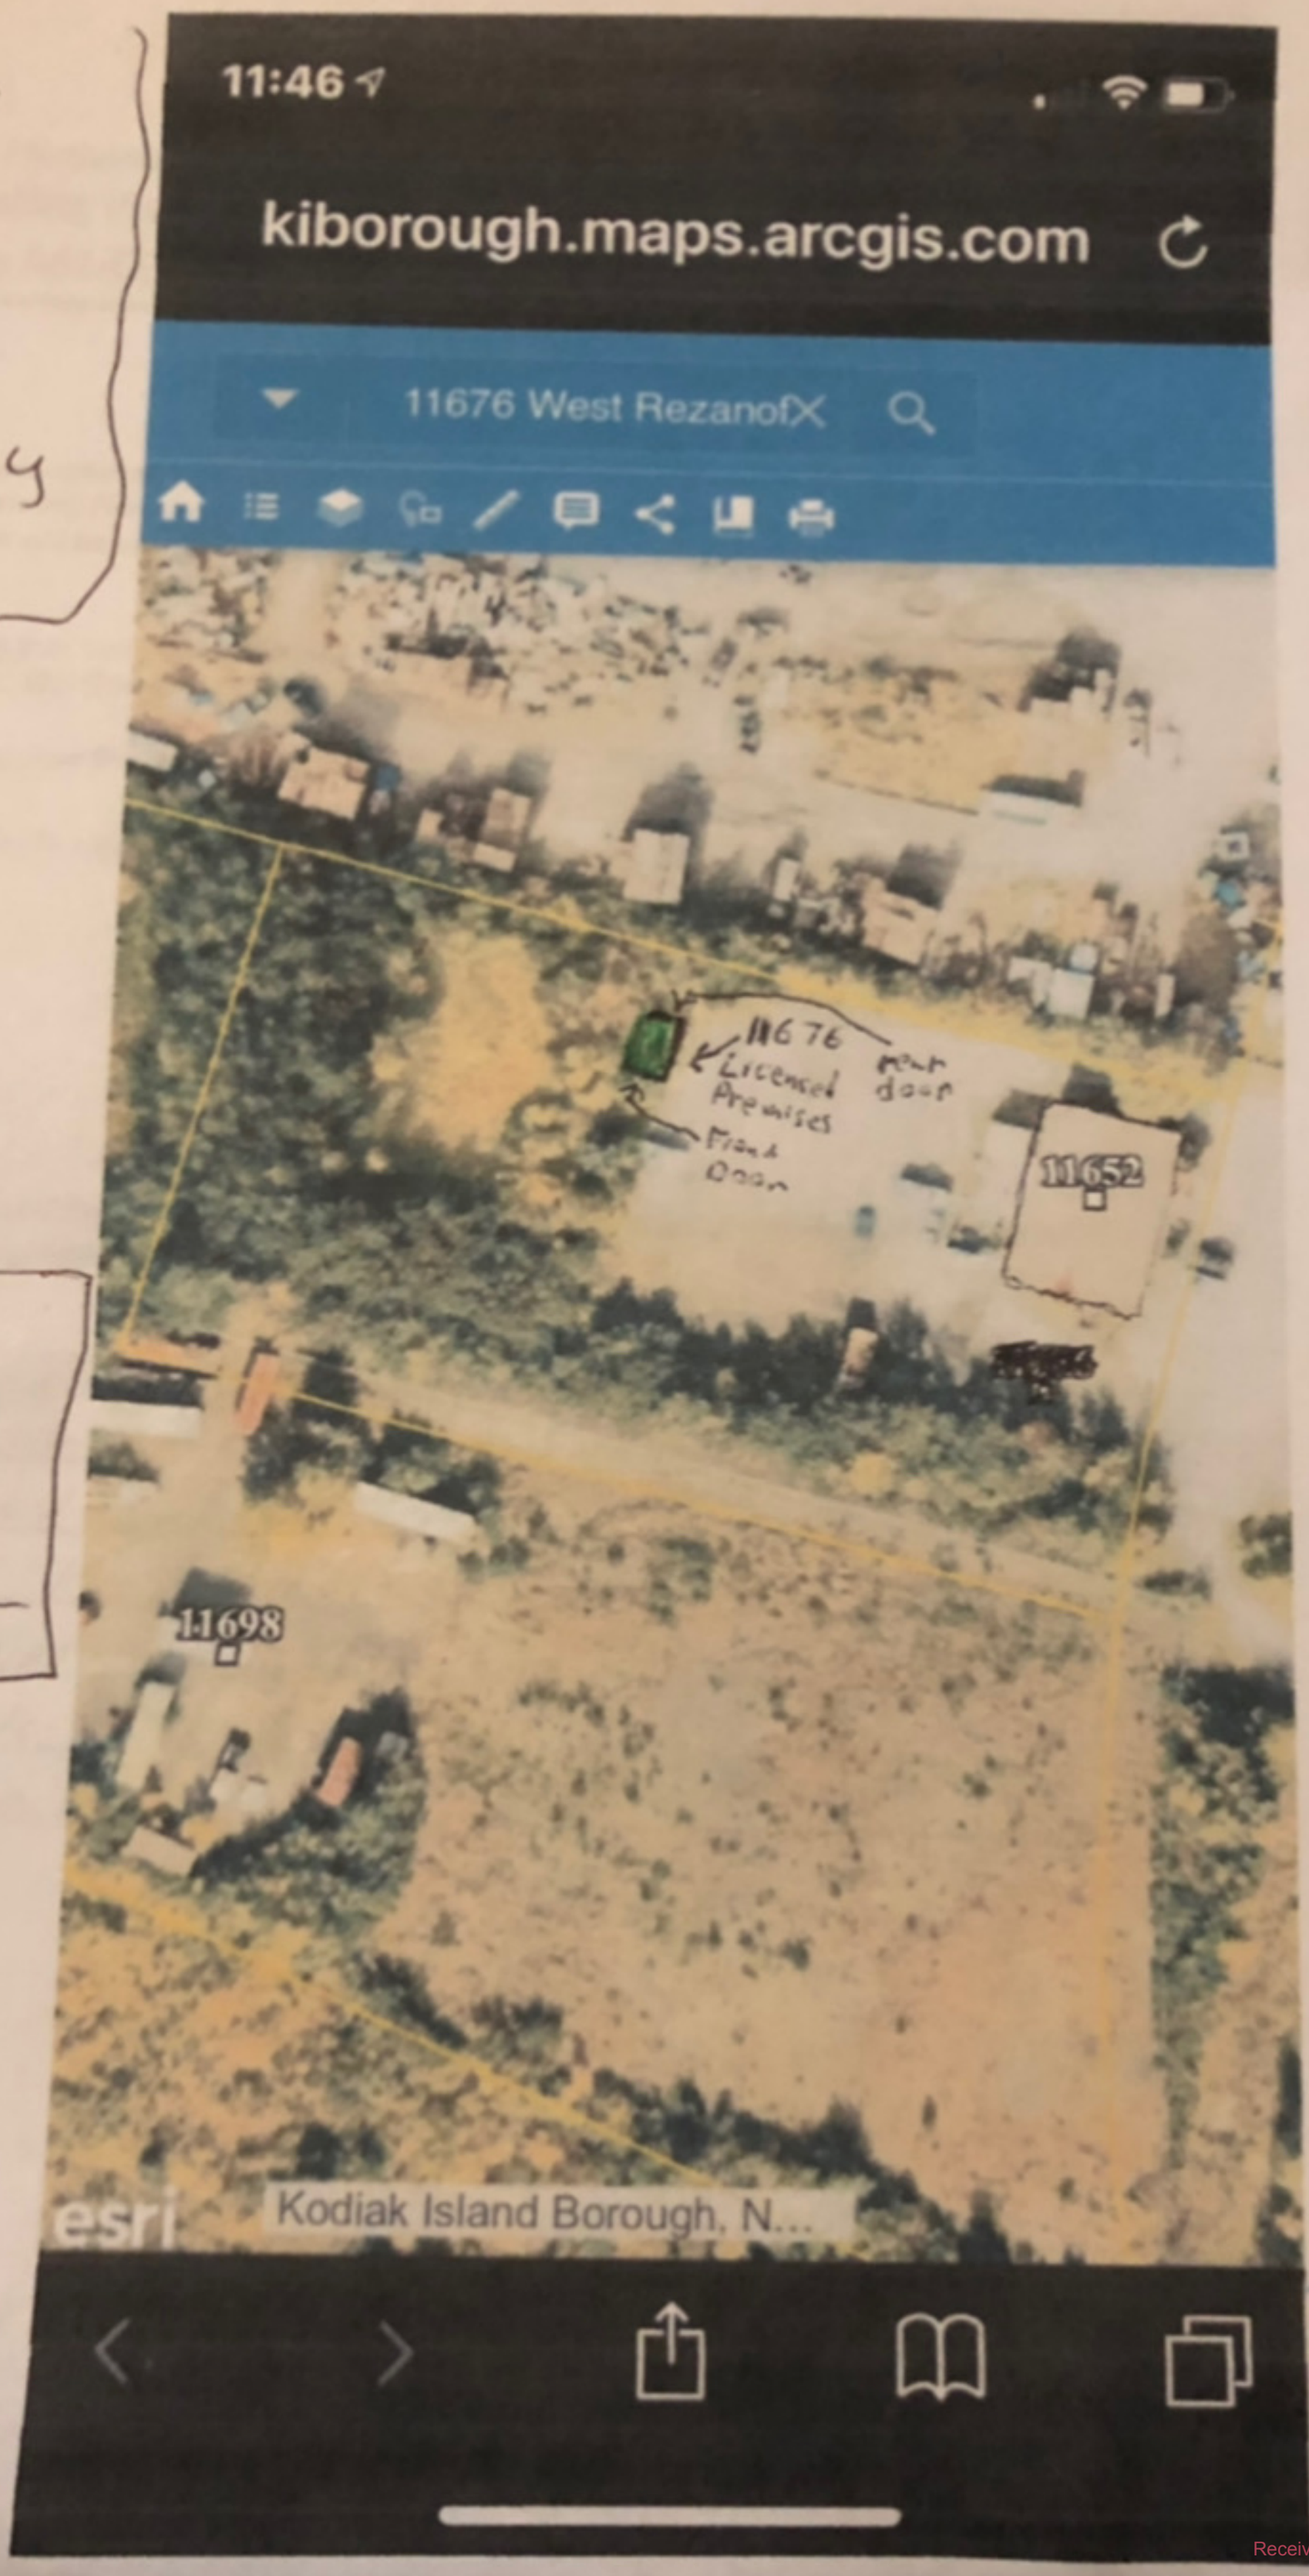

JAN 31 2019
Received by AMCO 3/14/19