Alcohol and Marijuana Control Office
550 W 7th Avenue, Suite 1600
Anchorage, AK 99501
marijuana.licensing@alaska.gov
https://www.commerce.alaska.gov/web/amco
Phone: 907.269.0350

Alaska Marijuana Control Board

Form MJ-02: Premises Diagram

What is this form?

A detailed diagram of the proposed licensed premises is required for all marijuana establishment license applications, per 3 AAC 306.020(b)(8). **All areas designated as the licensed premises of a single license must be contiguous.**

What must be submitted with this form?

Applicants must attach multiple diagrams to this form, including (as applicable):

- **Diagram 1:**
  a diagram showing only the licensed premises areas that will be ready to be **operational at the time of your preliminary inspection** and license issuance;

- **Diagram 2:**
  if different than Diagram 1, a diagram outlining **all areas for which the licensee has legal right of possession** (a valid lease or deed), and clearly showing those areas' relationship to the current proposed licensed premises *(details of any planned expansion areas do not need to be included; a complete copy of Form MJ-14: Licensed Premises Diagram Change must be submitted and approved before any planned expansion area may be added to the licensed premises);*

- **Diagram 3:**
  a **site plan or as-built of the entire lot**, showing all structures on the property and clearly indicating which area(s) will be part of the licensed premises;

- **Diagram 4:**
  an **aerial photo of the entire lot and surrounding lots**, showing a view of the entire property and surrounding properties, and clearly indicating which area(s) will be part of the licensed premises *(this can be obtained from sources like Google Earth)*; and

- **Diagram 5:**
  a diagram of the **entire building in which the licensed premises is located**, clearly distinguishing the licensed premises from unlicensed areas and/or premises of other licenses within the building. If your proposed licensed premises is located within a building or building complex that contains multiple business and/or tenants, please provide the addresses and/or suite numbers of the other businesses and/or tenants *(a separate diagram is not required for an establishment that is designating the entire building as a single licensed premises)*.

This form, and all necessary diagrams that meet the requirements on Page 2 of this form, must be completed and submitted to AMCO's main office before any new or transfer license application will be considered complete.

Section 1 – Establishment Information

Enter information for the business seeking to be licensed, as identified on the license application.

Licensee:	7107 Ventures, LLC	**MJ License #:**		17316	
License Type:	Marijuana Product Manufacturing Facility				
Doing Business As:	Arctic Delights				
Premises Address:	530 W 72nd, #1				
City:	Anchorage	**State:**	Alaska	**ZIP:**	99518

Received by AMCO 12.17.18
Received by AMCO 4.2.19

Alaska Marijuana Control Board

Form MJ-02: Premises Diagram

Section 2 – Required Information

For your security, do not include locations of security cameras, motion detectors, panic buttons, and other security devices.

The following details must be included in all diagrams:

- ☐ License number and DBA
- ☐ Legend or key
- ☐ Color coding
- ☐ Dimensions
- ☐ Labels
- ☐ True north arrow

The following additional details must be included in Diagram 1:

- ☐ Surveillance room
- ☐ Restricted access areas
- ☐ Storage areas
- ☐ Entrances, exits, and windows
- ☐ Walls, partitions, and counters
- ☐ Any other areas that must be labeled for specific license types

The following additional details must be included in Diagram 2:

- ☐ Areas of ingress and egress
- ☐ Entrances and exits
- ☐ Walls and partitions

The following additional details must be included in Diagrams 3 and 4:

- ☐ Areas of ingress and egress
- ☐ Cross streets and points of reference

The following additional details must be included in Diagram 5:

- ☐ Areas of ingress and egress
- ☐ Entrances and exits
- ☐ Walls and partitions
- ☐ Cross streets and points of reference

I declare under penalty of unsworn falsification that I have attached all necessary diagrams that meet the above requirements, and that this form, including all accompanying schedules, statements, and depictions is true, correct, and complete.

Signature of licensee

Bryant Thorp

Printed name of licensee

VALERIE MASTOLIER
Notary Public
State of Alaska
My Commission Expires Jun 7, 2022

Notary Public in and for the State of Alaska

My commission expires: 6/7/22

Subscribed and sworn to before me this 18 day of September, 2018.

Received by AMCO 12.17.18
Received by AMCO 4.2.19

From: Jana Weltzin
To: Marijuana Licensing (CED sponsored)
Cc: Brenda Mills; Bryant Thorp; Valerie Mastolier; Jana Weltzin
Subject: FW: Part 3 of 3 Arctic Delights license number 17316 - incomplete response
Date: Tuesday, April 02, 2019 5:44:14 PM
Attachments: Tincture.pdf
MJ-02.pdf
Pot Rocksidw.pdf

HI AMCO team! Pls see attached documents and responses to your items below:

- Your original Diagram 1 was better than your revised one: I can't read the legend or the labels including the restricted access area, licensed premises, and not restricted access area labels. I really don't want to go back and forth on the diagram, please take the time to get me a good one.

  We used the top settings on our scanner – I hope this looks okay, pls review and let me know if it addresses your concerns. Attached revised MJ02

- The stairs in the manufacturing facility, by the bathroom, where do they lead to? The upstairs that is in orange/ 'existing storage'? is there a separate entrance to the upstairs besides the proposed MJ manufacturing facility? Provide your answers in writing to be provided to the board.

The stairs lead upstairs to a private office space that is unlicensed and used only by the licensee. To your question of whether there is a separate entrance to the upstairs besides going thru the proposed MJ facility, the answer is no there is not. However the upstairs office will be used only by Bryant (the licensee) and the storage will just be storage of non-marijuana items (aka Bryant's personal storage). Did you want a letter format to respond to this question or does this email suffice?

- Arctic Pot Rocks: in the Packaging Description section, you need to specifically state the serving-size amount of the product, not just say "Up to 1 gram", that will contain 5mg of THC.

  ATTACHED and revised per your guidance above.
- Tincture: on your revised Tincture, you left out the serving size indicator. So will it be on the bottle or on the pipette. Please indicate it on your revised Tincture, and show on the picture.

  ATTACHED and revised per your guidance above.

Pls let us know if you need anything else to deem this application complete jana

existing storage is non-marijuana storage

= non licensed area

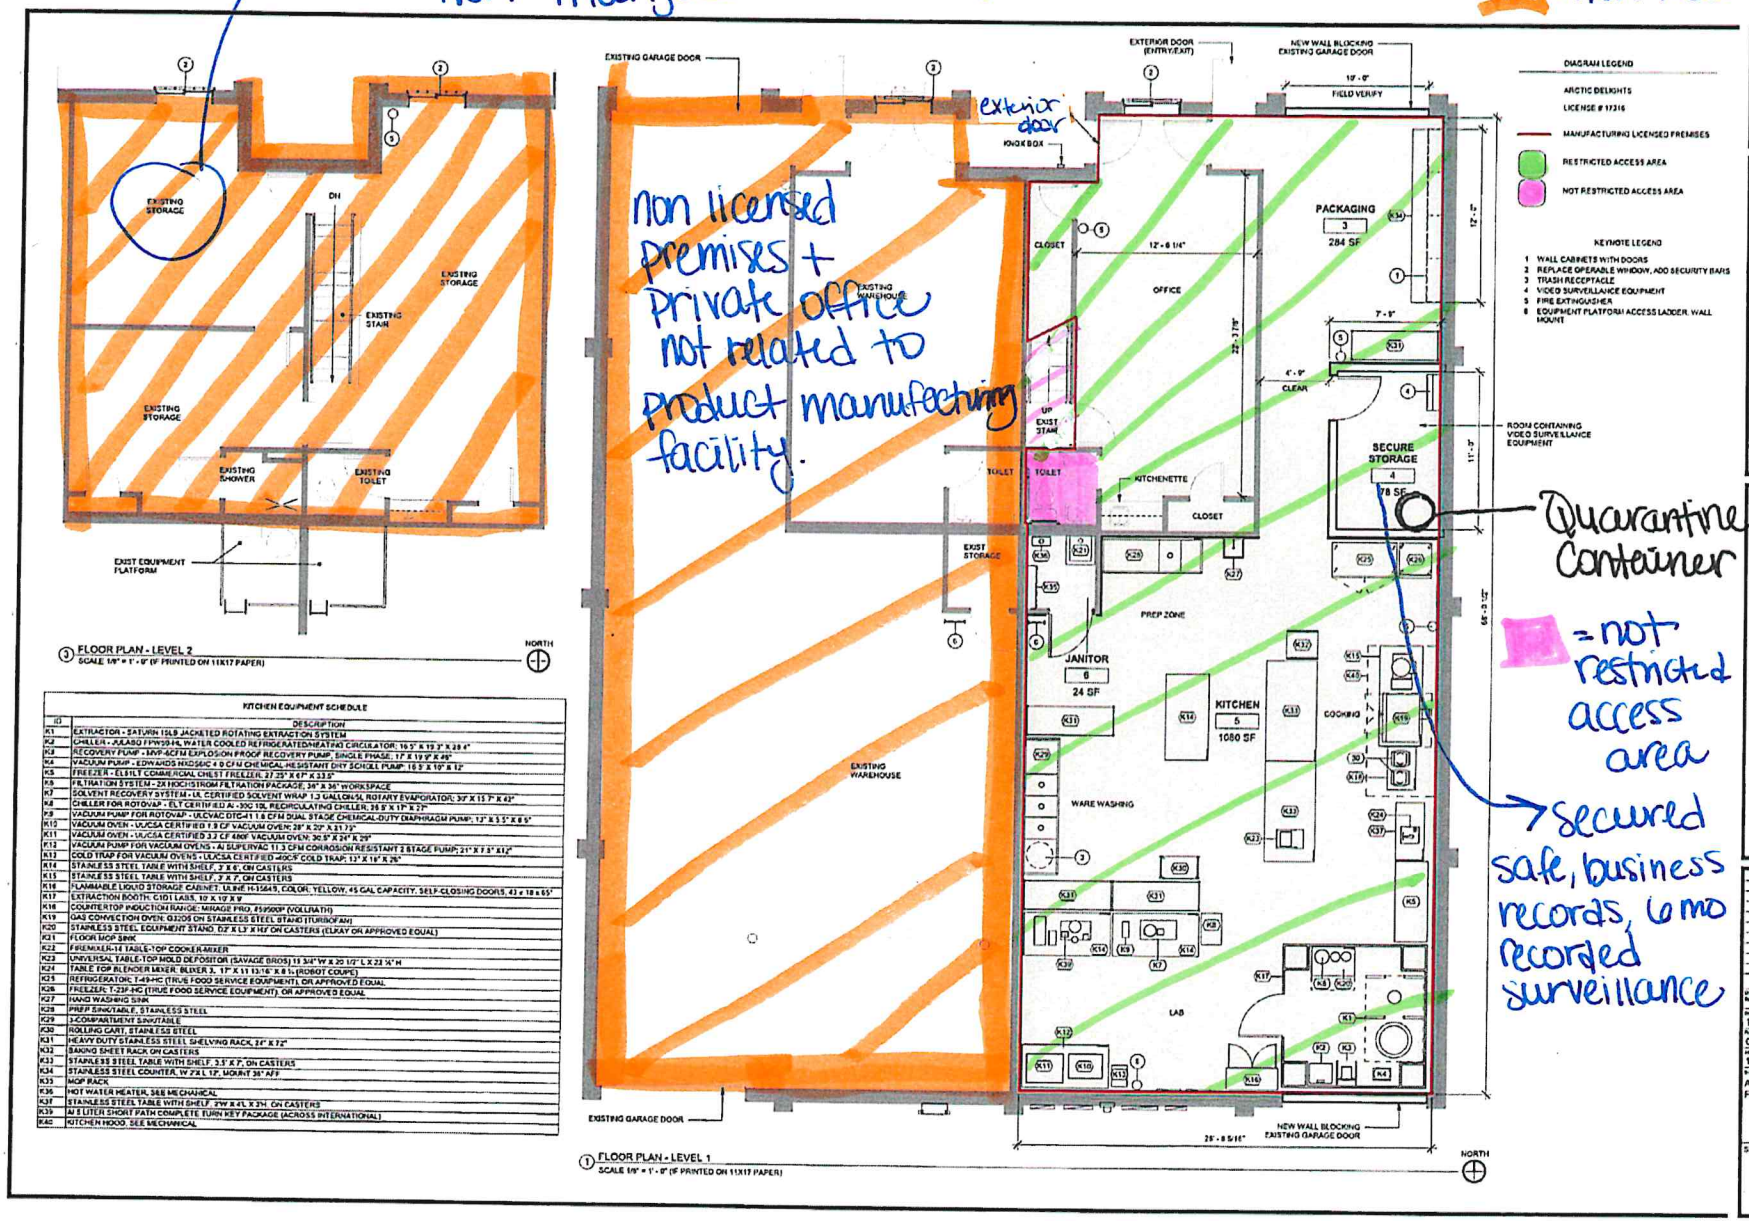

KITCHEN EQUIPMENT SCHEDULE

ID	DESCRIPTION
K1	EXTRACTOR - SATURN 15LB JACKETED ROTATING EXTRACTION SYSTEM
K2	CHILLER - JULABO FPW50-HL WATER COOLED REFRIGERATED/HEATED CIRCULATOR; 16.5" X 19.3" X 28.4"
K3	RECOVERY PUMP - MVP-6CFM EXPLOSION PROOF RECOVERY PUMP, SINGLE PHASE, 17" X 19.9" X 46"
K4	VACUUM PUMP - EDWARDS NXDS6C 4.9 CFM CHEMICAL-RESISTANT DRY SCROLL PUMP; 16.5" X 10" X 12"
K5	FREEZER - ELSILT COMMERCIAL CHEST FREEZER; 27.25" X 47" X 33.5"
K6	FILTRATION SYSTEM - 2X HOCHSTROM FILTRATION PACKAGE, 36" X 36" WORKSPACE
K7	SOLVENT RECOVERY SYSTEM - UL CERTIFIED SOLVENT WRAP 1.3 GALLON/SL ROTARY EVAPORATOR; 30" X 15.7" X 43"
K8	CHILLER FOR ROTOVAP - ELT CERTIFIED AL-300 10L RECIRCULATING CHILLER; 26.5" X 17" X 27"
K9	VACUUM PUMP FOR ROTOVAP - UEVAC DTC-41 1.6 CFM DUAL STAGE CHEMICAL-DUTY DIAPHRAGM PUMP; 12" X 5.5" X 8.5"
K10	VACUUM OVEN - UUCSA CERTIFIED 1.9 CF VACUUM OVEN; 28" X 22" X 21.72"
K11	VACUUM OVEN - UUCSA CERTIFIED 3.3 CF 480F VACUUM OVEN; 30.5" X 24" X 29"
K12	VACUUM PUMP FOR VACUUM OVENS - AI SUPERVAC 11.3 CFM CORROSION RESISTANT 2 STAGE PUMP; 21" X 7.5" X 12"
K13	COLD TRAP FOR VACUUM OVENS - UUCSA CERTIFIED -40C/F COLD TRAP; 13" X 16" X 26"
K14	STAINLESS STEEL TABLE WITH SHELF, 3' X 6', ON CASTERS
K15	STAINLESS STEEL TABLE WITH SHELF, 3' X 7', ON CASTERS
K16	FLAMMABLE LIQUID STORAGE CABINET; ULINE H-15649, COLOR: YELLOW, 45 GAL CAPACITY, SELF-CLOSING DOORS, 43 x 18 x 65"
K17	EXTRACTION BOOTH: CIDI LABS, 10' X 10' X 9'
K18	COUNTERTOP INDUCTION RANGE: MIRAGE PRO, #59500P (VOLLRATH)
K19	GAS CONVECTION OVEN: G3205 ON STAINLESS STEEL STAND (TURBOFAN)
K20	STAINLESS STEEL EQUIPMENT STAND, D2' X L3' X H3' ON CASTERS (ELKAY OR APPROVED EQUAL)
K21	FLOOR MOP SINK
K22	FIREMIXER-14 TABLE-TOP COOKER-MIXER
K23	UNIVERSAL TABLE-TOP MOLD DEPOSITOR (SAVAGE BROS) 13 3/4" W X 20 1/2" L X 22 1/4" H
K24	TABLE TOP BLENDER MIXER; BLINER 3, 1/2" X 11 13/16" X 8 ½ (ROBOT COUPE)
K25	REFRIGERATOR: T-49-HC (TRUE FOOD SERVICE EQUIPMENT), OR APPROVED EQUAL
K26	FREEZER: T-23F-HC (TRUE FOOD SERVICE EQUIPMENT), OR APPROVED EQUAL
K27	HAND WASHING SINK
K28	PREP SINK/TABLE, STAINLESS STEEL
K29	3-COMPARTMENT SINK/TABLE
K30	ROLLING CART, STAINLESS STEEL
K31	HEAVY DUTY STAINLESS STEEL SHELVING RACK, 24" X 72"
K32	BAKING SHEET RACK ON CASTERS
K33	STAINLESS STEEL TABLE WITH SHELF, 3.5' X 7', ON CASTERS
K34	STAINLESS STEEL COUNTER, W 2'-L 12', MOUNT 36" AFF
K35	MOP RACK
K36	HOT WATER HEATER, SEE MECHANICAL
K37	STAINLESS STEEL TABLE WITH SHELF, 2'W X 4'L X 3'H, ON CASTERS
K39	AI 5 LITER SHORT PATH COMPLETE TURN KEY PACKAGE (ACROSS INTERNATIONAL)
K40	KITCHEN HOOD, SEE MECHANICAL

Received by AMCO 12.17.18
Received by AMCO 4.2.19

Arctic Delights
#17316

Diagram 1

= non licensed premises

= area licensee has right to possess

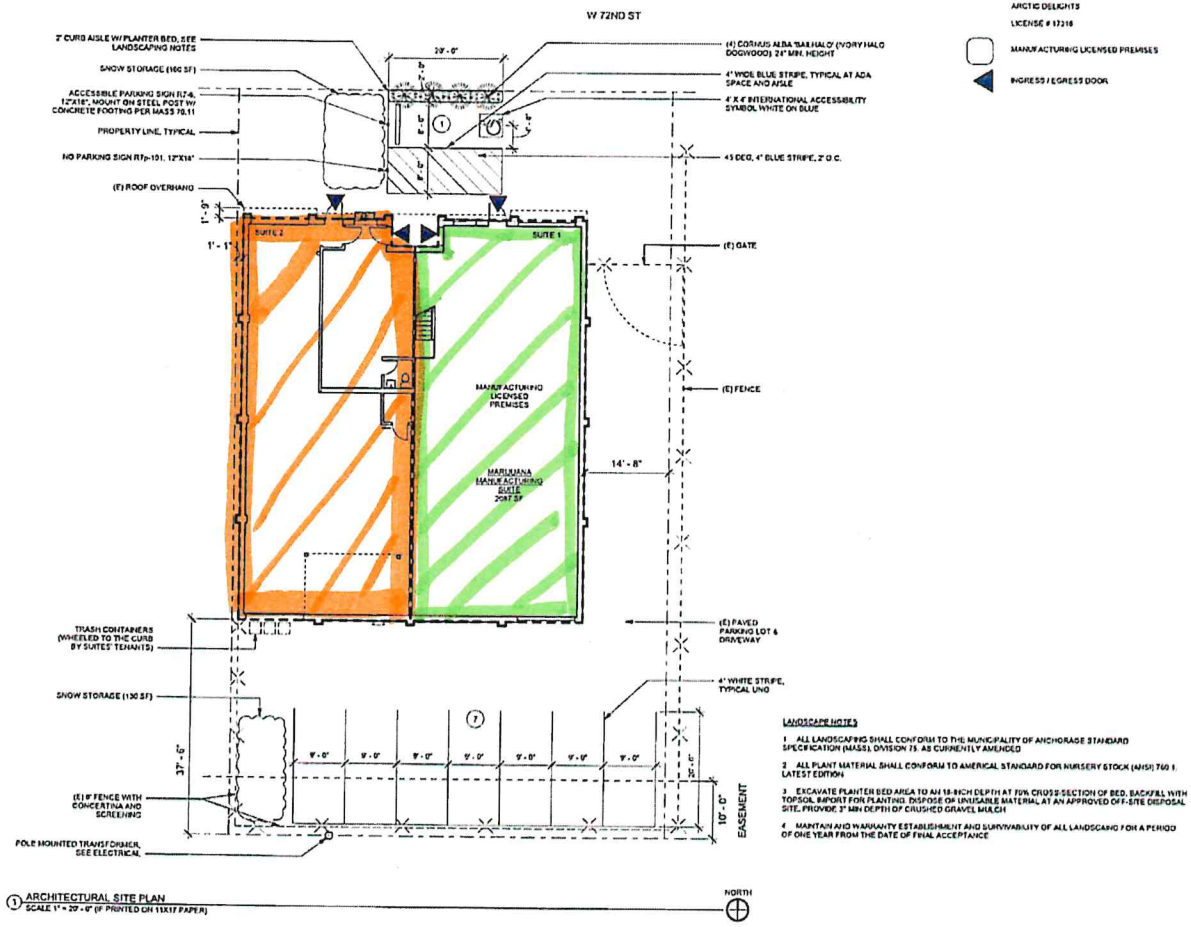

LANDSCAPE NOTES

1. ALL LANDSCAPING SHALL CONFORM TO THE MUNICIPALITY OF ANCHORAGE STANDARD SPECIFICATION (MASS), DIVISION 75, AS CURRENTLY AMENDED
2. ALL PLANT MATERIAL SHALL CONFORM TO AMERICAL STANDARD FOR NURSERY STOCK (ANSI) Z60.1, LATEST EDITION
3. EXCAVATE PLANTER BED AREA TO AN 18-INCH DEPTH AT 70% CROSS-SECTION OF BED, BACKFILL WITH TOPSOIL IMPORT FOR PLANTING. DISPOSE OF UNUSABLE MATERIAL AT AN APPROVED OFF-SITE DISPOSAL SITE. PROVIDE 3" MIN DEPTH OF CRUSHED GRAVEL MULCH
4. MAINTAIN AND WARRANTY ESTABLISHMENT AND SURVIVABILITY OF ALL LANDSCAPING FOR A PERIOD OF ONE YEAR FROM THE DATE OF FINAL ACCEPTANCE

1 ARCHITECTURAL SITE PLAN
SCALE 1" = 20' - 0" (IF PRINTED ON 11X17 PAPER)

ICEFALL Architecture LLC
2207 Cottonwood Street, Anchorage, AK P: (907)727-4427

ARCTIC DELIGHTS
MANUFACTURING FACILITY
530 West 72nd Avenue, Suite 1, Anchorage, Alaska

No.	Description	Date

Drawn by: MK
Checked by: MK
Date: 12-11-2018
Plan: CO-1
Job No.: 1713
Sheet Title: AMCO DIAGRAM - SITE PLAN
SHEET NO: A2

Received by AMCO 12.17.18
Received by AMCO 4.2.19

Arctic Delights
#17316

Diagram 2 + 3

License #17316 D/B/A Arctic Delights

- proposed licensed premises.

Diagram #4 + 5

N

Received by AMCO 3.28.19
Received by AMCO 4.2.19