Alcohol & Marijuana Control Office
550 W 7th Avenue, Suite 1600
Anchorage, AK 99501
marijuana.licensing@alaska.gov
https://www.commerce.alaska.gov/web/amco
Phone: 907.269.0350

Alaska Marijuana Control Board

Cover Sheet for Marijuana Establishment Applications

What is this form?

This cover sheet **must** be completed and submitted any time a document, payment, or other marijuana establishment application item is emailed, mailed, or hand-delivered to AMCO's main office.

Items that are submitted without this page will be returned in the manner in which they were received.

Section 1 – Establishment Information

Enter information for the business seeking to be licensed, as identified on the license application.

Licensee:	Alaska Forget Me Not Farms, LLC	**License Number:**	19984		
License Type:	Limited Marijuana Cultivation Facility				
Doing Business As:	ALASKA FORGET ME NOT FARMS, LLC				
Physical Address:	1540 N. SHORELINE DRIVE				
City:	WASILLA	**State:**	AK	**Zip Code:**	99654 - 6666
Designated Licensee:	Stuart Wells				
Email Address:	akforgetmenotfarms@gmail.com				

Section 2 – Attached Items

List all documents, payments, and other items that are being submitted along with this page.

Attached Items:	MJ-02 Licensed Premises Diagrams

OFFICE USE ONLY					
Received Date:		Payment Submitted Y/N:		Transaction #:	

AMCO
JUN 25 2019

Alcohol and Marijuana Control Office
550 W 7th Avenue, Suite 1600
Anchorage, AK 99501
marijuana.licensing@alaska.gov
https://www.commerce.alaska.gov/web/amco
Phone: 907.269.0350

Alaska Marijuana Control Board

Form MJ-02: Premises Diagram

What is this form?

A detailed diagram of the proposed licensed premises is required for all marijuana establishment license applications, per 3 AAC 306.020(b)(8). **All areas designated as the licensed premises of a single license must be contiguous.**

What must be submitted with this form?

Applicants must attach multiple diagrams to this form, including (as applicable):

- **Diagram 1:**
  a diagram showing only the licensed premises areas that will be ready to be **operational at the time of your preliminary inspection** and license issuance;

- **Diagram 2:**
  if different than Diagram 1, a diagram outlining **all areas for which the licensee has legal right of possession** (a valid lease or deed), and clearly showing those areas' relationship to the current proposed licensed premises *(details of any planned expansion areas do not need to be included; a complete copy of Form MJ-14: Licensed Premises Diagram Change must be submitted and approved before any planned expansion area may be added to the licensed premises);*

- **Diagram 3:**
  a **site plan or as-built of the entire lot**, showing all structures on the property and clearly indicating which area(s) will be part of the licensed premises;

- **Diagram 4:**
  an **aerial photo of the entire lot and surrounding lots**, showing a view of the entire property and surrounding properties, and clearly indicating which area(s) will be part of the licensed premises *(this can be obtained from sources like Google Earth)*; and

- **Diagram 5:**
  a diagram of the **entire building in which the licensed premises is located**, clearly distinguishing the licensed premises from unlicensed areas and/or premises of other licenses within the building. If your proposed licensed premises is located within a building or building complex that contains multiple business and/or tenants, please provide the addresses and/or suite numbers of the other businesses and/or tenants *(a separate diagram is not required for an establishment that is designating the entire building as a single licensed premises)*.

This form, and all necessary diagrams that meet the requirements on Page 2 of this form, must be completed and submitted to AMCO's main office before any new or transfer license application will be considered complete.

Section 1 – Establishment Information

Enter information for the business seeking to be licensed, as identified on the license application.

Licensee:	Alaska Forget Me Not Farms, LLC	**MJ License #:**	19984		
License Type:	LIMITED CULTIVATION FACILITY				
Doing Business As:	ALASKA FORGET ME NOT FARMS, LLC				
Premises Address:	1540 N. SHORELINE DRIVE				
City:	WASILLA	**State:**	Alaska	**ZIP:**	99654

AMCO
JUN 25 2019

Alaska Marijuana Control Board

Form MJ-02: Premises Diagram

Section 2 – Required Information

For your security, do not include locations of security cameras, motion detectors, panic buttons, and other security devices.

The following details must be included in all diagrams:

- [x] License number and DBA
- [x] Legend or key
- [x] Color coding
- [x] Dimensions
- [x] Labels
- [x] True north arrow

The following additional details must be included in Diagram 1:

- [x] Surveillance room
- [x] Restricted access areas
- [x] Storage areas
- [x] Entrances, exits, and windows
- [x] Walls, partitions, and counters
- [x] Any other areas that must be labeled for specific license types

The following additional details must be included in Diagram 2:

- [x] Areas of ingress and egress
- [x] Entrances and exits
- [x] Walls and partitions

The following additional details must be included in Diagrams 3 and 4:

- [x] Areas of ingress and egress
- [x] Cross streets and points of reference

The following additional details must be included in Diagram 5:

- [x] Areas of ingress and egress
- [x] Entrances and exits
- [x] Walls and partitions
- [x] Cross streets and points of reference

I declare under penalty of unsworn falsification that I have attached all necessary diagrams that meet the above requirements, and that this form, including all accompanying schedules, statements, and depictions is true, correct, and complete.

Signature of licensee

STUART WELLS

Printed name of licensee

Notary Public in and for the State of Alaska

My commission expires: 06/07/2025

Subscribed and sworn to before me this 17th day of June, 2019.

License# 19984
DBA: Alaska Forget Me Not Farms

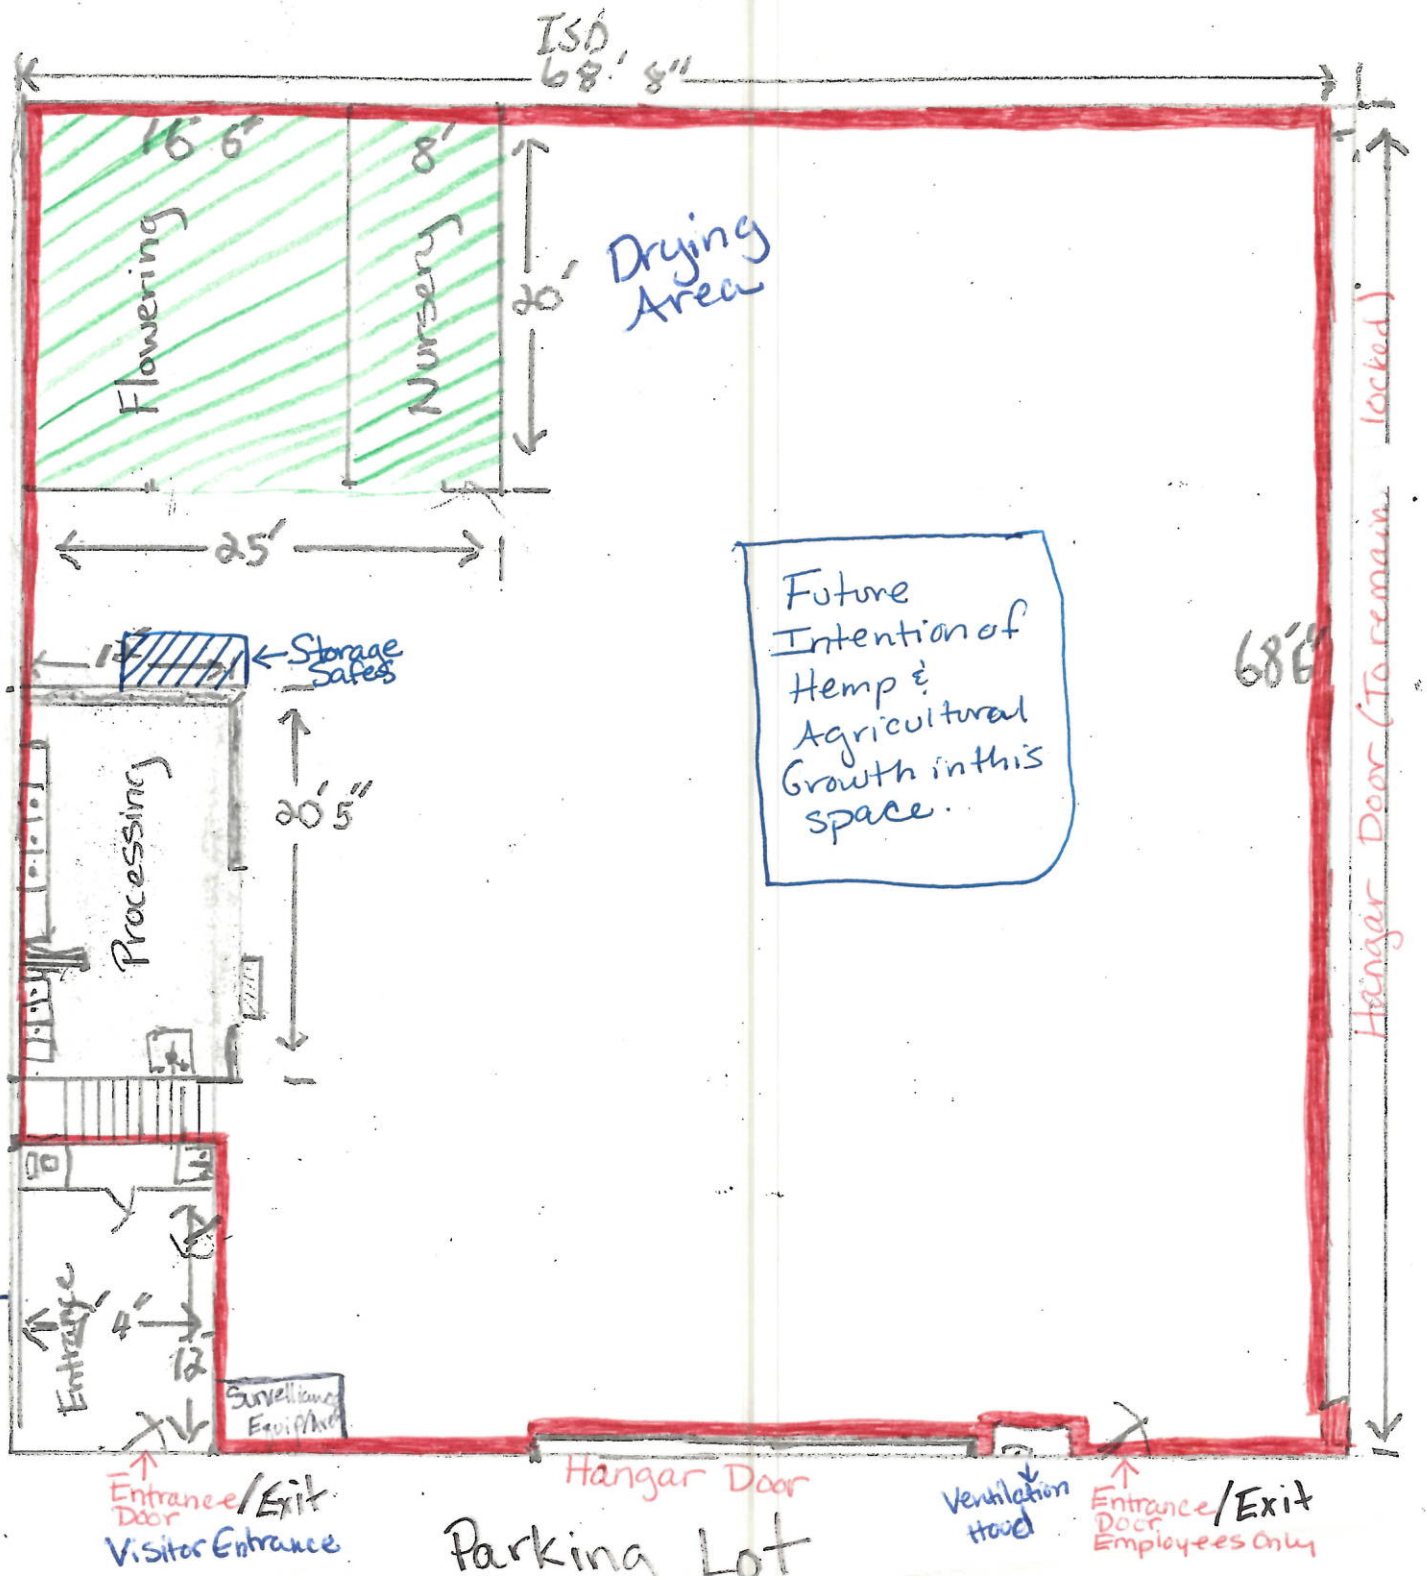

AMCO
JUN 25 2019

Restricted Access
Cannabis Cultivation

Diagram 1
Diagram 2
Diagram 5

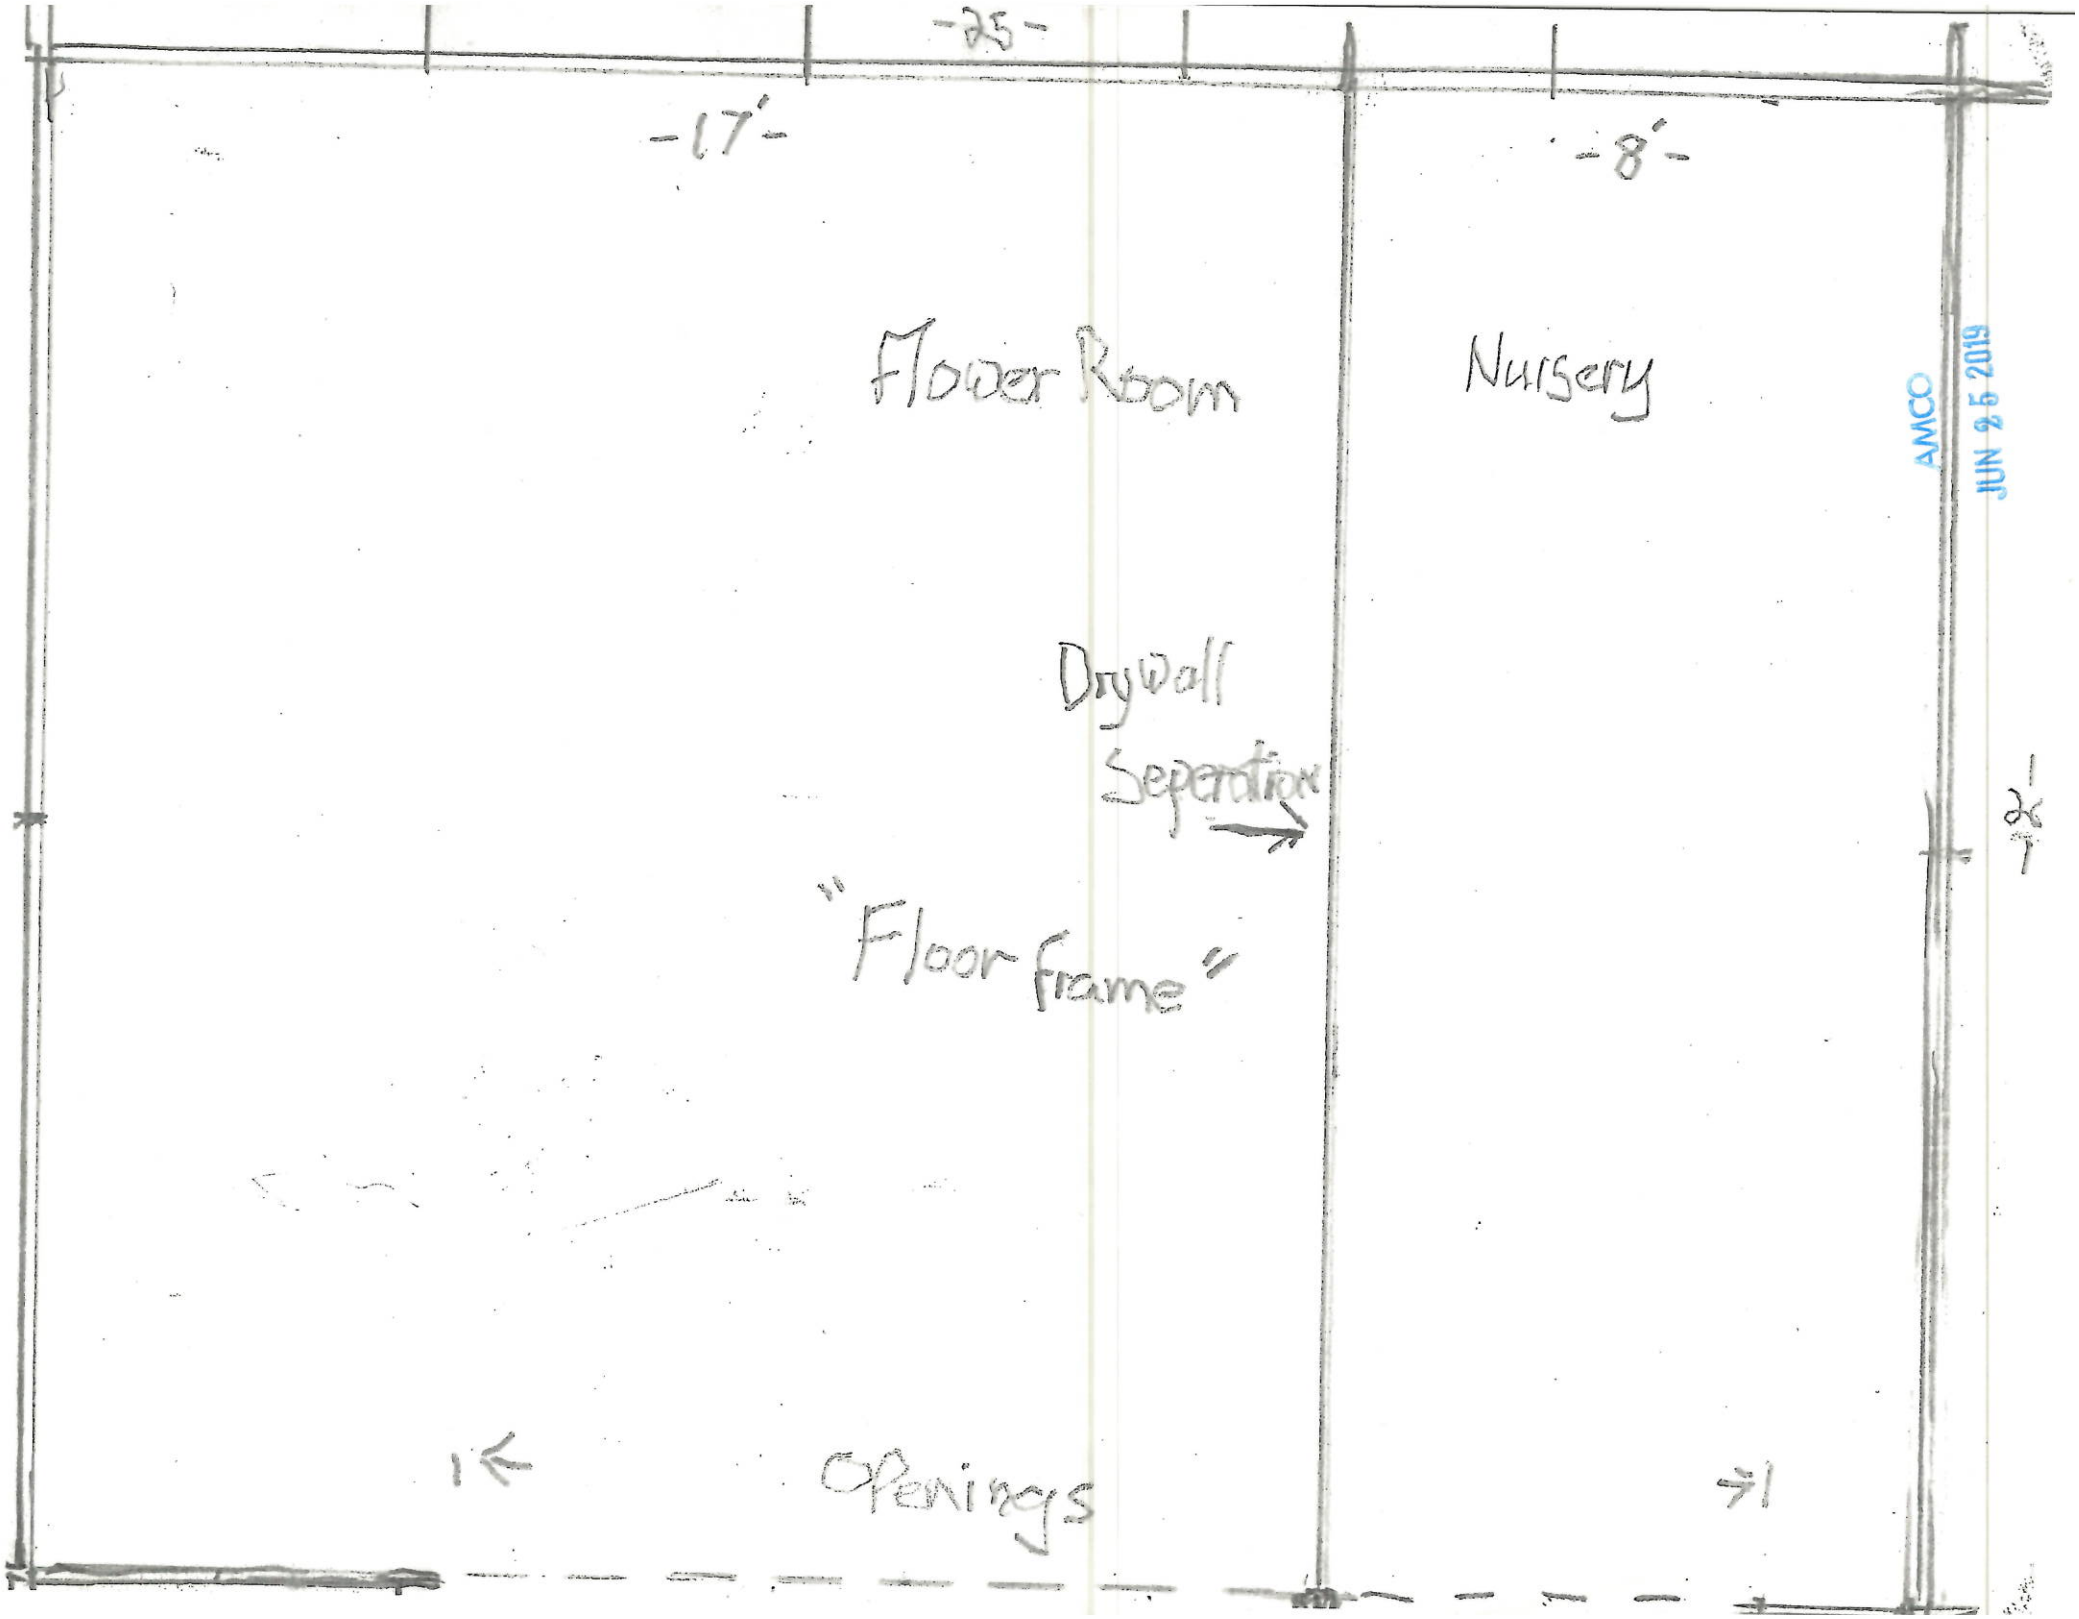
-25-
-17'-
-8'-
Flower Room
Nursery
Drywall
Separation
"Floor frame"
Openings
AMCO
JUN 25 2019

Diagram 3

Site Plan

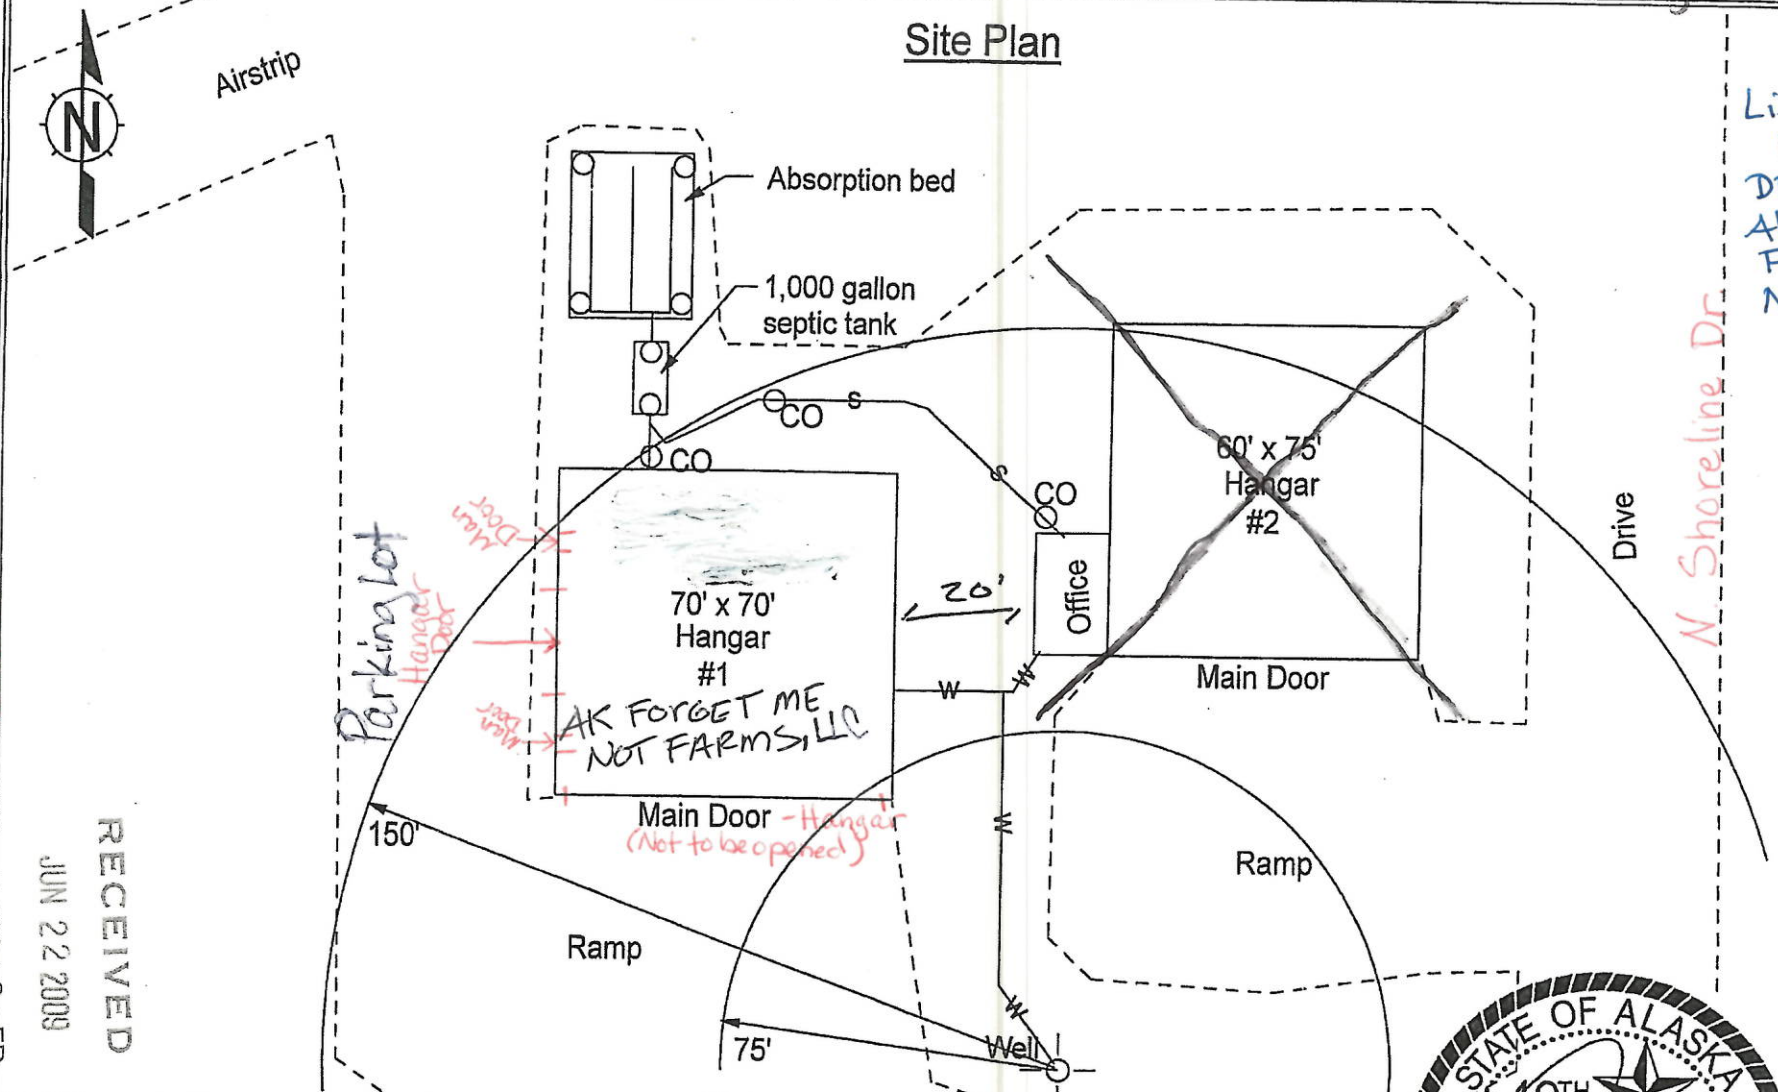

License #: 19984
DBA: Alaska Forget Me Not Farms

RECEIVED
JUN 22 2009
Central Mat-Su FD

JUN 25 2019

TP A12 S6 T17N R1E SM Gattis Hangars
Class C Water / Wastewater System Asbuilt

HOLLER ENGINEERING
3375 N Sams Dr. Wasilla, Alaska 99654

Job # 99033C	5-24-09	no scale

Notes

1. This septic system does not lie within the protective radius of any known well.
2. No survey staking provided - lotlines/easements are owner's/developer's responsibility.
3. Lead free m materials were used exclusively. Water line bured +10', wellhead grouted.

STATE OF ALASKA
49TH
CURTIS E. HOLLER
CE 9607
REGISTERED PROFESSIONAL ENGINEER

Diagram 3
Lic #19984
Alaska Forget Me Not Farms LLC

Site Plan

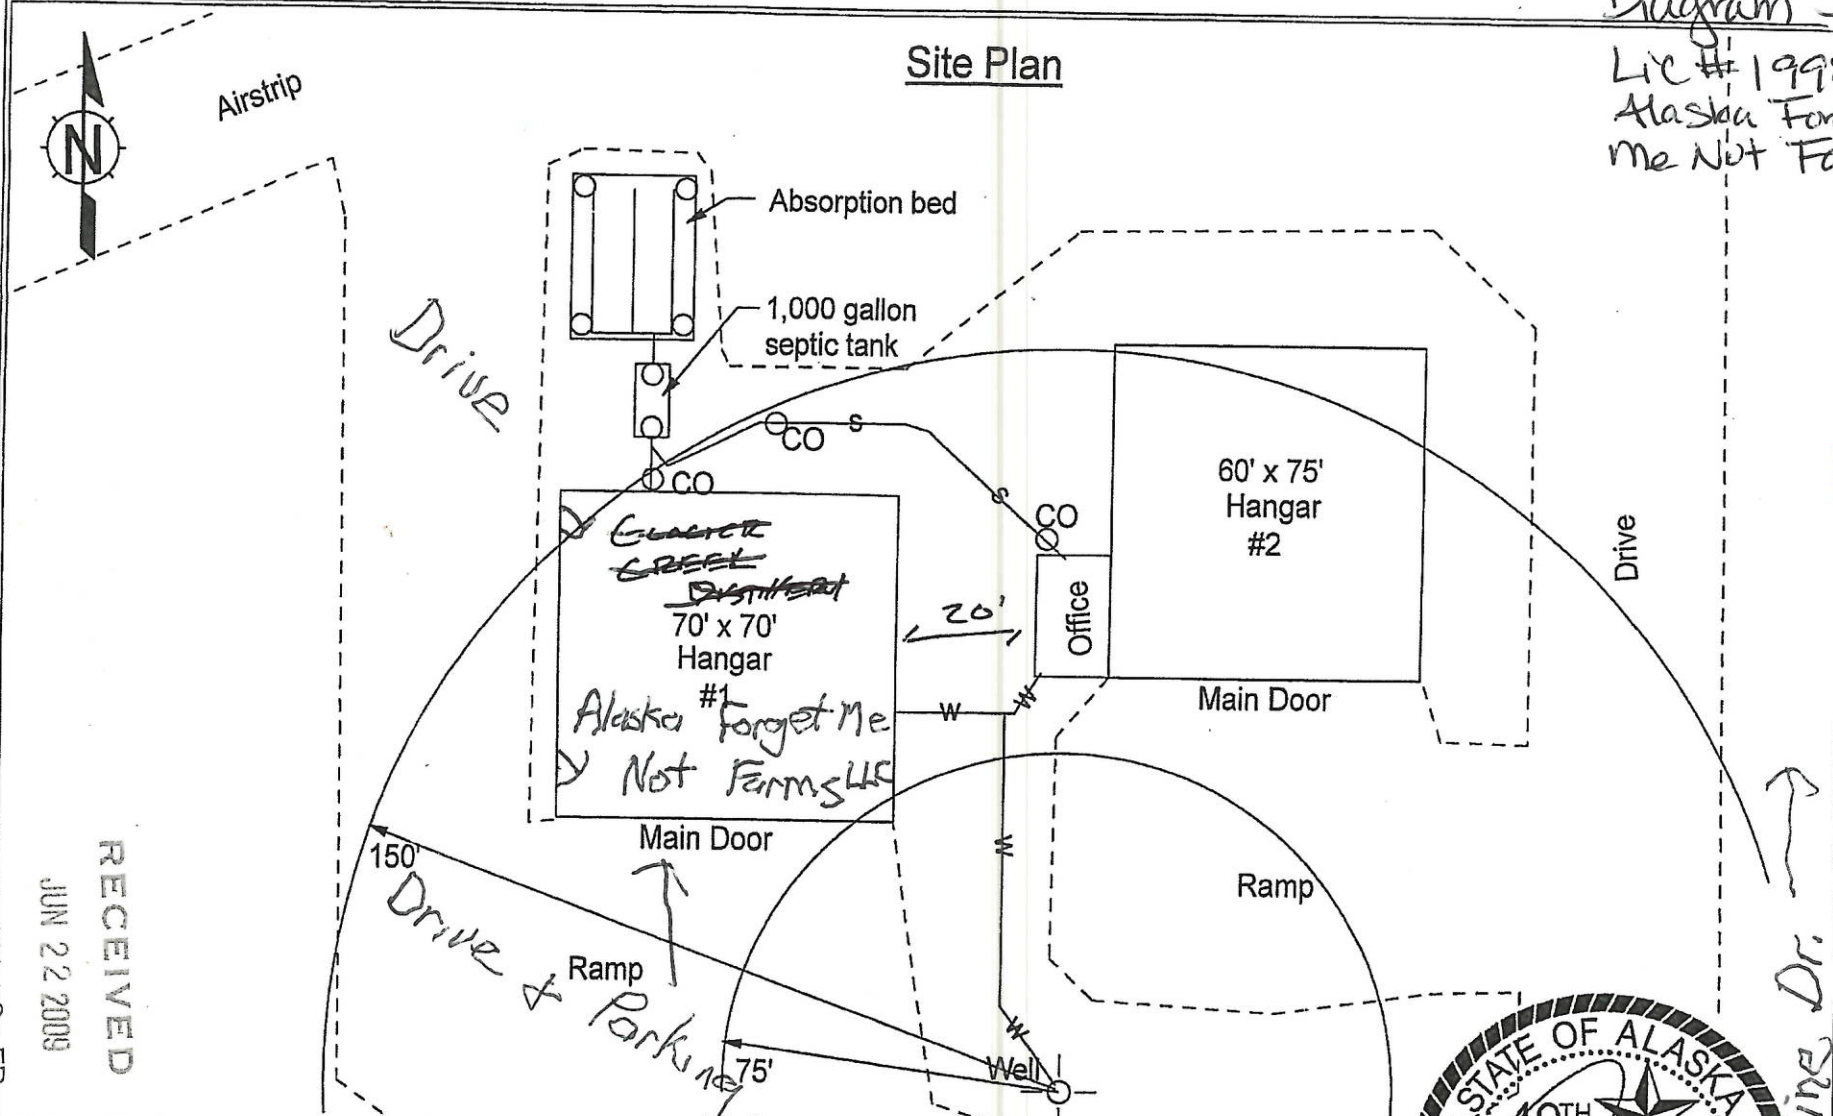

RECEIVED
JUN 22 2009
Central Mat-Su FD

AMCO
JUN 25 2019

TP A12 S6 T17N R1E SM Gattis Hangars
Class C Water / Wastewater System Asbuilt

HOLLER ENGINEERING
3375 N Sams Dr. Wasilla, Alaska 99654

Job # 99033C	5-24-09	no scale

Notes

1. This septic system does not lie within the protective radius of any known well.
2. No survey staking provided - lotlines/easements are owner's/developer's responsibility.
3. Lead free m materials were used exclusively. Water line bured +10', wellhead grouted.

STATE OF ALASKA
49TH
CURTIS E. HOLLER
CE 9607
REGISTERED PROFESSIONAL ENGINEER

Google Maps

1540 N Shoreline Dr

Proposed Licensed Premises of Alaska Forget Me Not Farms LCF

Imagery ©2019 DigitalGlobe, Map data ©2019 Google 200 ft

N Shoreline Dr.

Diagram 4

1540 N Shoreline Dr

Wasilla, AK 99654

License # 19984

DBA: Alaska Forget Me Not Farms, LLC

Building & Property Overhead view

AMCO

JUN 25 2019

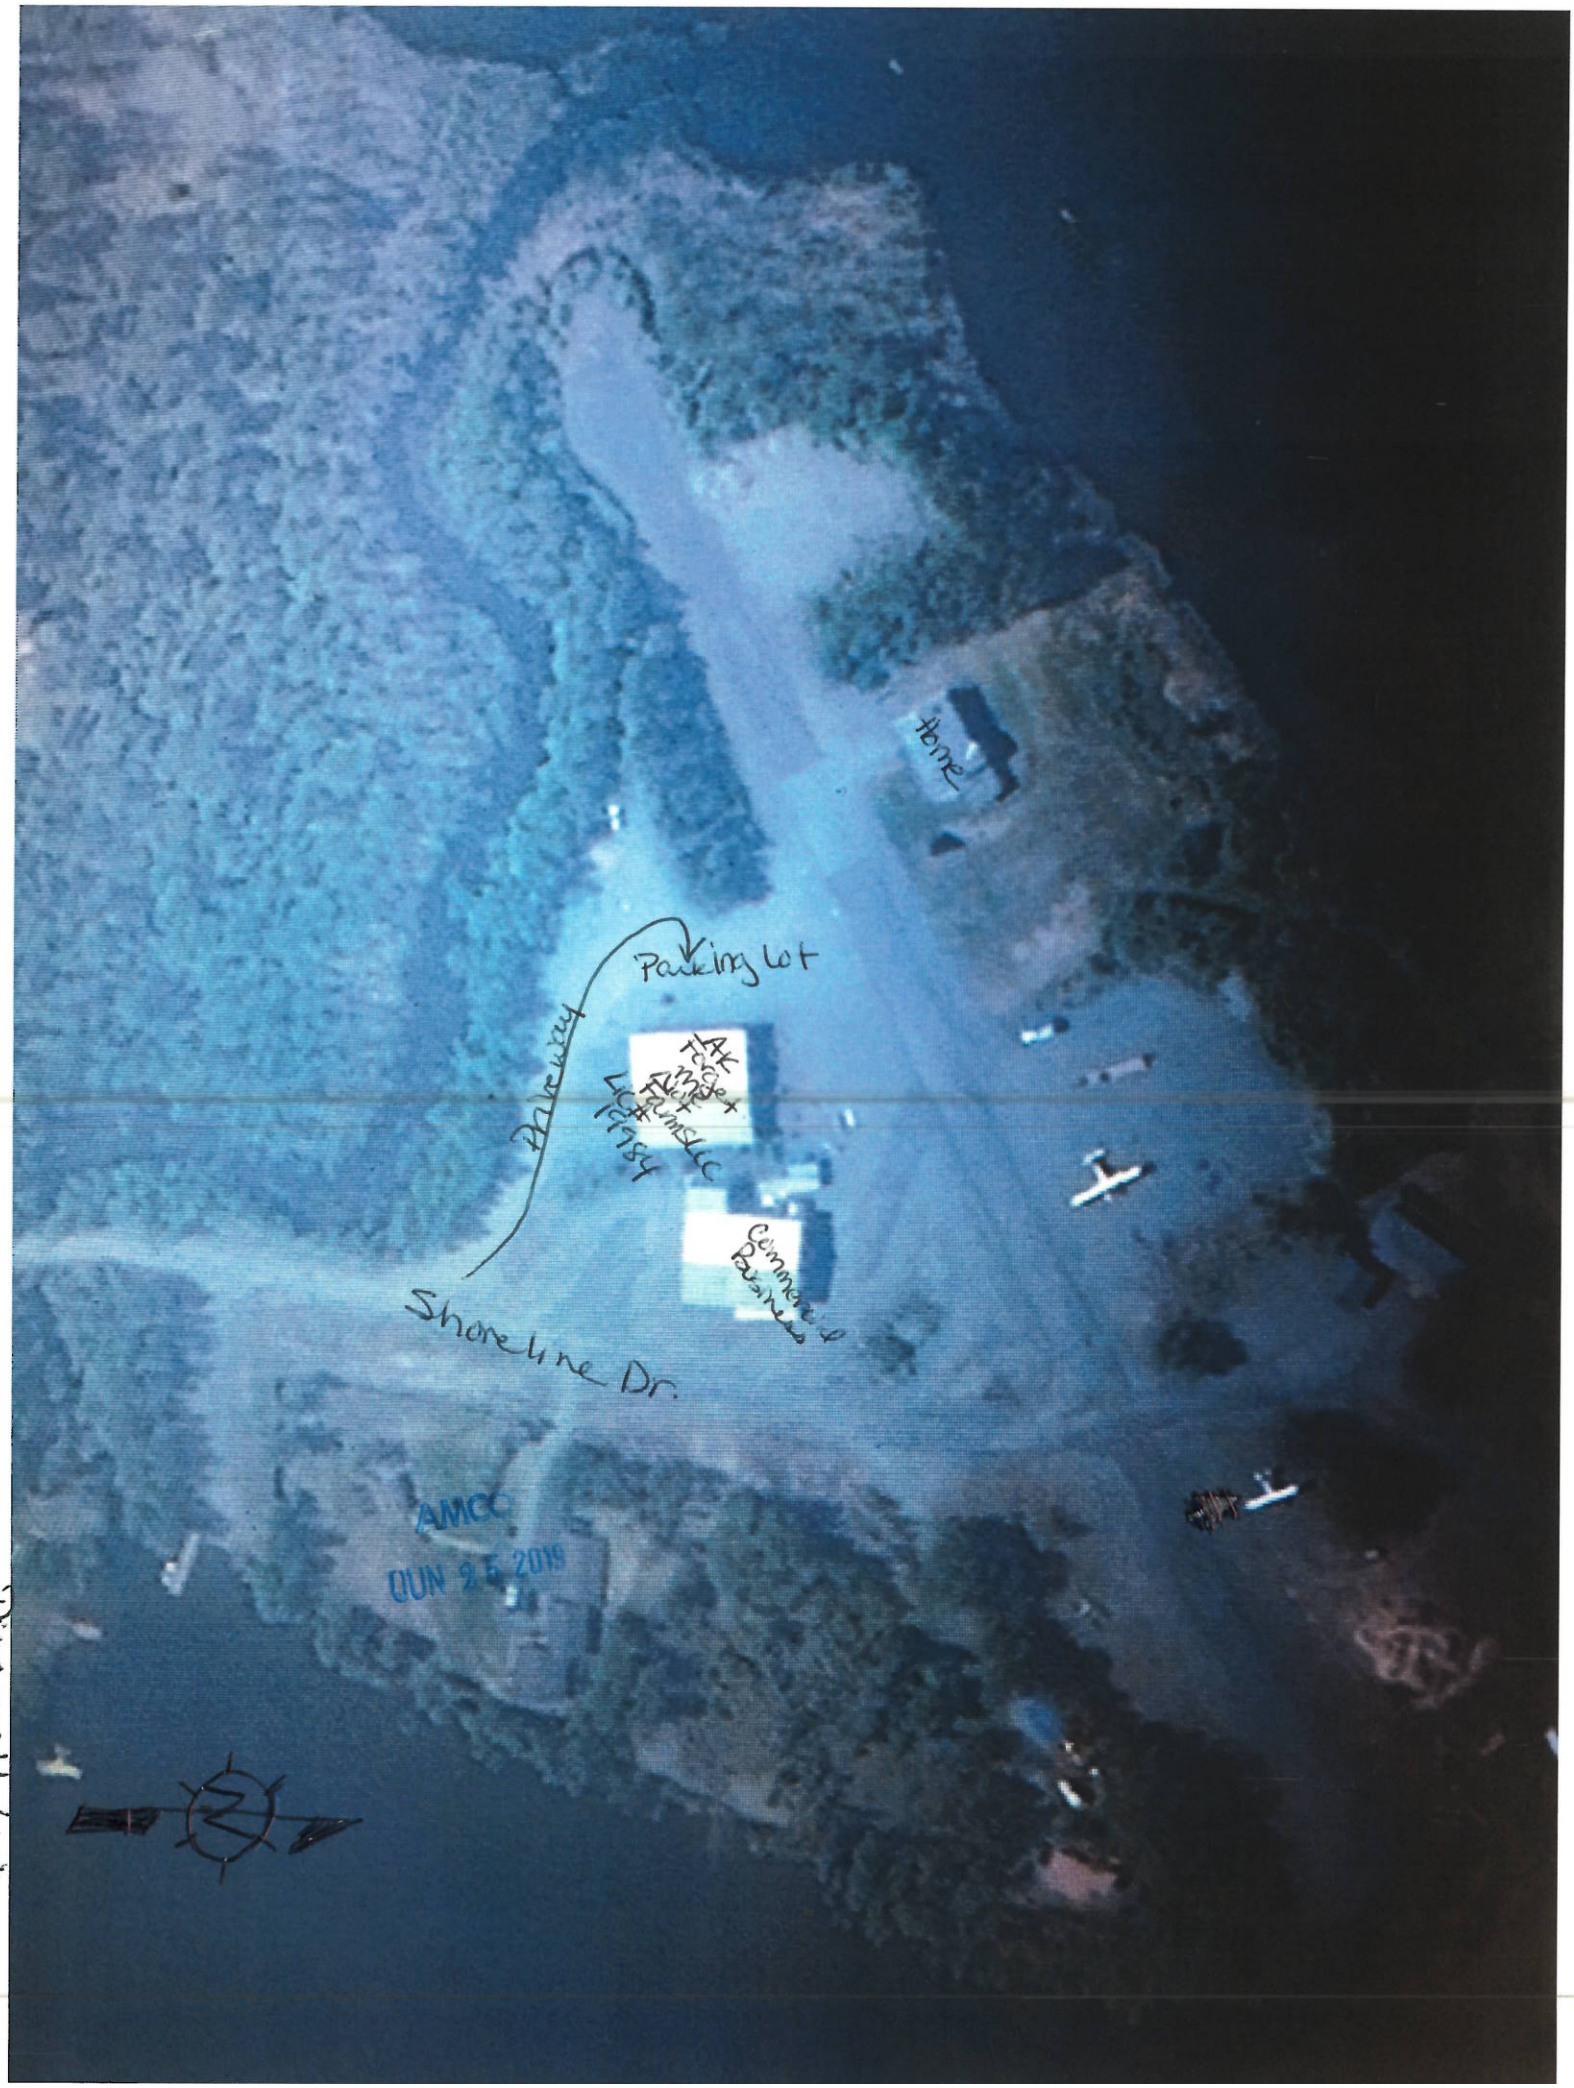

Diagram 4 cont

Document 4, 2 of 2