MJ-14 in case it is needed. MJ-14 is currently in the review process at AMCO.

Alcohol & Marijuana Control Office
550 W 7th Avenue, Suite 1600
Anchorage, AK 99501
marijuana.licensing@alaska.gov
https://www.commerce.alaska.gov/web/amco
Phone: 907.269.0350

Alaska Marijuana Control Board

Cover Sheet for Marijuana Establishment Applications

What is this form?

This cover sheet **must** be completed and submitted any time a document, payment, or other marijuana establishment application item is emailed, mailed, or hand-delivered to AMCO's main office.

Items that are submitted without this page will be returned in the manner in which they were received.

Section 1 – Establishment Information

Enter information for the business seeking to be licensed, as identified on the license application.

Licensee:	Alaska Wild Coyote, Inc.	**License Number:**		12125	
License Type:	Standard Marijuana Cultivation Facility				
Doing Business As:	ALASKA MARIJUANA GARDENS (AMG)				
Physical Address:	838 Bonanza Avenue				
City:	Anchorage	**State:**	AK	**Zip Code:**	99518 - 1707
Designated Licensee:	Carmen Villamides				
Email Address:	silvia@gci.net				

Section 2 – Attached Items

List all documents, payments, and other items that are being submitted along with this page.

Attached Items:	Revised MJ-14 (Current Form) Minor Changes requested by Jacqlene Drulis Copy of Building Permit #C17-2155

OFFICE USE ONLY					
Received Date:		Payment Submitted Y/N:		Transaction #:	

RECEIVED
DEC 19 2018
ALCOHOL MARIJUANA CONTROL OFFICE
STATE OF ALASKA

Alcohol and Marijuana Control Office
550 W 7th Avenue, Suite 1600
Anchorage, AK 99501
marijuana.licensing@alaska.gov
https://www.commerce.alaska.gov/web/amco
Phone: 907.269.0350

Alaska Marijuana Control Board

Form MJ-14: Licensed Premises Diagram Change

What is this form?

This licensed premises diagram change form is required for all marijuana establishment licensees seeking to alter the functional floor plan or reduce or expand the area of the establishment's existing licensed premises.
The required $250 change fee may be made by check, cashier's check, or money order.

This form must be completed and submitted to AMCO's main office prior to altering the existing floor plan, and along with an initiated application for an Onsite Consumption Endorsement if applicable. The licensed premises may not be altered unless and until the application has been approved by the board.

Section 1 – Establishment Information

Enter information for the business seeking to be licensed, as identified on the license application.

Licensee:	Alaska Wild Coyote, Inc.	**MJ License #:**	12125		
License Type:	Standard Marijuana Cultivation Facility				
Doing Business As:	Alaska Marijuana Gardens (AMG)				
Premises Address:	838 Bonanza Avenue				
City:	Anchorage	**State:**	Alaska	**ZIP:**	99518

Section 2 – Required Information

For your security, do not include locations of security cameras, motion detectors, panic buttons, and other security devices.

The following details must be included:

- ☐ **License number and DBA**
- ☐ **Legend or key**
- ☐ **Color coding**
- ☐ **Dimensions**
- ☐ **Labels**
- ☐ **True north arrow**
- ☐ **Surveillance room**
- ☐ **Licensed premises boundary**
- ☐ **Restricted access areas**
- ☐ **Storage areas**
- ☐ **Entrances, exits, and windows**
- ☐ **Walls, partitions, and counters**
- ☐ **Any other areas that must be labeled for specific license types**
- ☐ **Serving area****
- ☐ **Employee monitoring area****
- ☐ **Ventilation exhaust points, if applicable****

RECEIVED
DEC 19 2013
ALCOHOL MARIJUANA CONTROL OFFICE
ALASKA

Items marked with a double asterisks (**) are only required for those retail marijuana establishments that are submitting the MJ-14 form in conjunction with an onsite consumption endorsement application.

Form MJ-14: Licensed Premises Diagram Change

Section 3 – Summary of Changes

Provide a summary of the changes for which you are requesting approval.

The Electrical room has increased in size. The office has decreased in size. The bathroom door and electrical door have changed locations, and a couple of walls have been removed. The overall square footage of the building has not changed.

Section 4 – Declarations

Read each statement below, and then sign your initials in the corresponding box to the right [if applicable]: Initials

If a local building permit is required, I have attached a copy of it to this form. [ ]

The proposed changes conform to all applicable public health, fire, and safety laws. [ ]

I have included a title, lease or other documentation showing sole right of possession to the additional area(s) if the additional area(s) are not already part of my approved licensed premises. [ ]

As a marijuana establishment licensee, I declare under penalty of unsworn falsification that this form, including all accompanying schedules and statements, is true, correct, and complete.

Signature of licensee

Armando Gonzalez

Printed name of licensee

NOTARY PUBLIC
VINCENT WOLFSTURM
STATE OF ALASKA
MY COMMISSION EXPIRES January 01, 2022

Notary Public in and for the State of Alaska.

My commission expires: Jan 01, 2022

Subscribed and sworn to before me this 13th day of December, 2019.

RECEIVED
DEC 19 2019
ALCOHOL & MARIJUANA CONTROL OFFICE
STATE OF ALASKA

Alaska Marijuana Control Board

Form MJ-14: Licensed Premises Diagram Change

Section 5 – Approvals

Local Government Review is required to be completed before submission to the Alcohol and Marijuana Control Office.

Local Government Review (to be completed by an appropriate local government official):	Yes	No	Pending
The proposed changes shown on this form conform to all local restrictions and laws.	☑	☐	☐
A local building permit is required for the proposed changes.	☑	☐	

Signature of local government official: [signature]

Building Permit #: _____

Date: 12/17/19

Printed name of local government official: Dave Whitfield

Title: Current Planning Manager

Section 6 – AMCO Review

AMCO Review:	Approved	Disapproved
	☐	☐

Signature of AMCO Enforcement Supervisor: _____

Signature of Director: _____

Printed name of AMCO Enforcement Supervisor: _____

Printed name of Director: _____

Date: _____

AMCO Comments:

RECEIVED DEC 19 2019 ALCOHOL & MARIJUANA CONTROL OFFICE

License # 12125

DBA = Alaska Marijuana Gardens (AMG)

Security = Surveillance Room

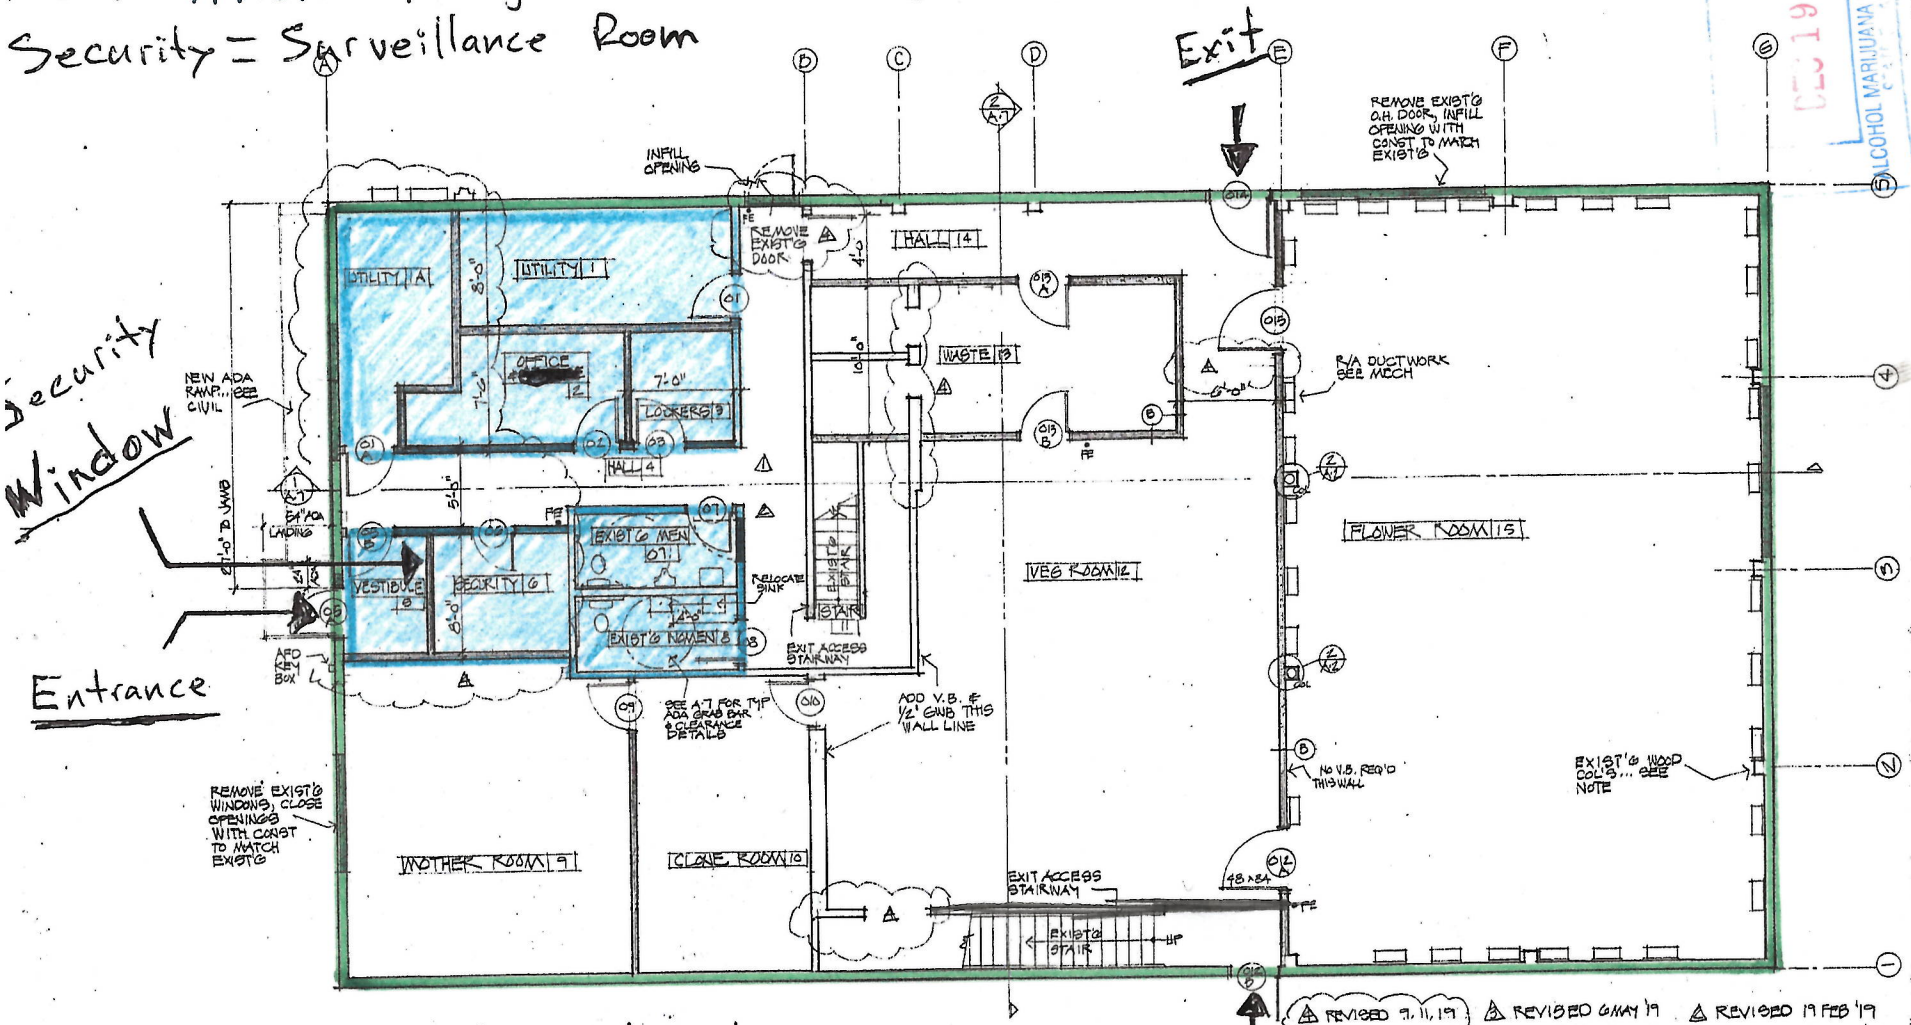

Green = Cultivation | Restricted Access Area and Licensed premesis

Red = Proposed Concentrates | Restricted Access

Blue = Licensed premesis / Unrestricted, Non Marijuana Storage

DEC 19 2019
ALCOHOL MARIJUANA CONTROL OFFICE

AMG Grow Site Building Alterations
838 Bonanza Avenue, Anchorage

Gordon Thompson Architect
711 M STREET, SUITE 101 ANCHORAGE, ALASKA 99501 (907) 279-2554

DRAWN	GORDO
CHECKED	G.T.
DATE	6.25.18
JOB NO.	0127
SHEET NO.	A-3
OF	A-7

...GALLO...

License # 12125

DBA = Alaska Marijuana Gordens (AMG)

Security = Surveillance Room

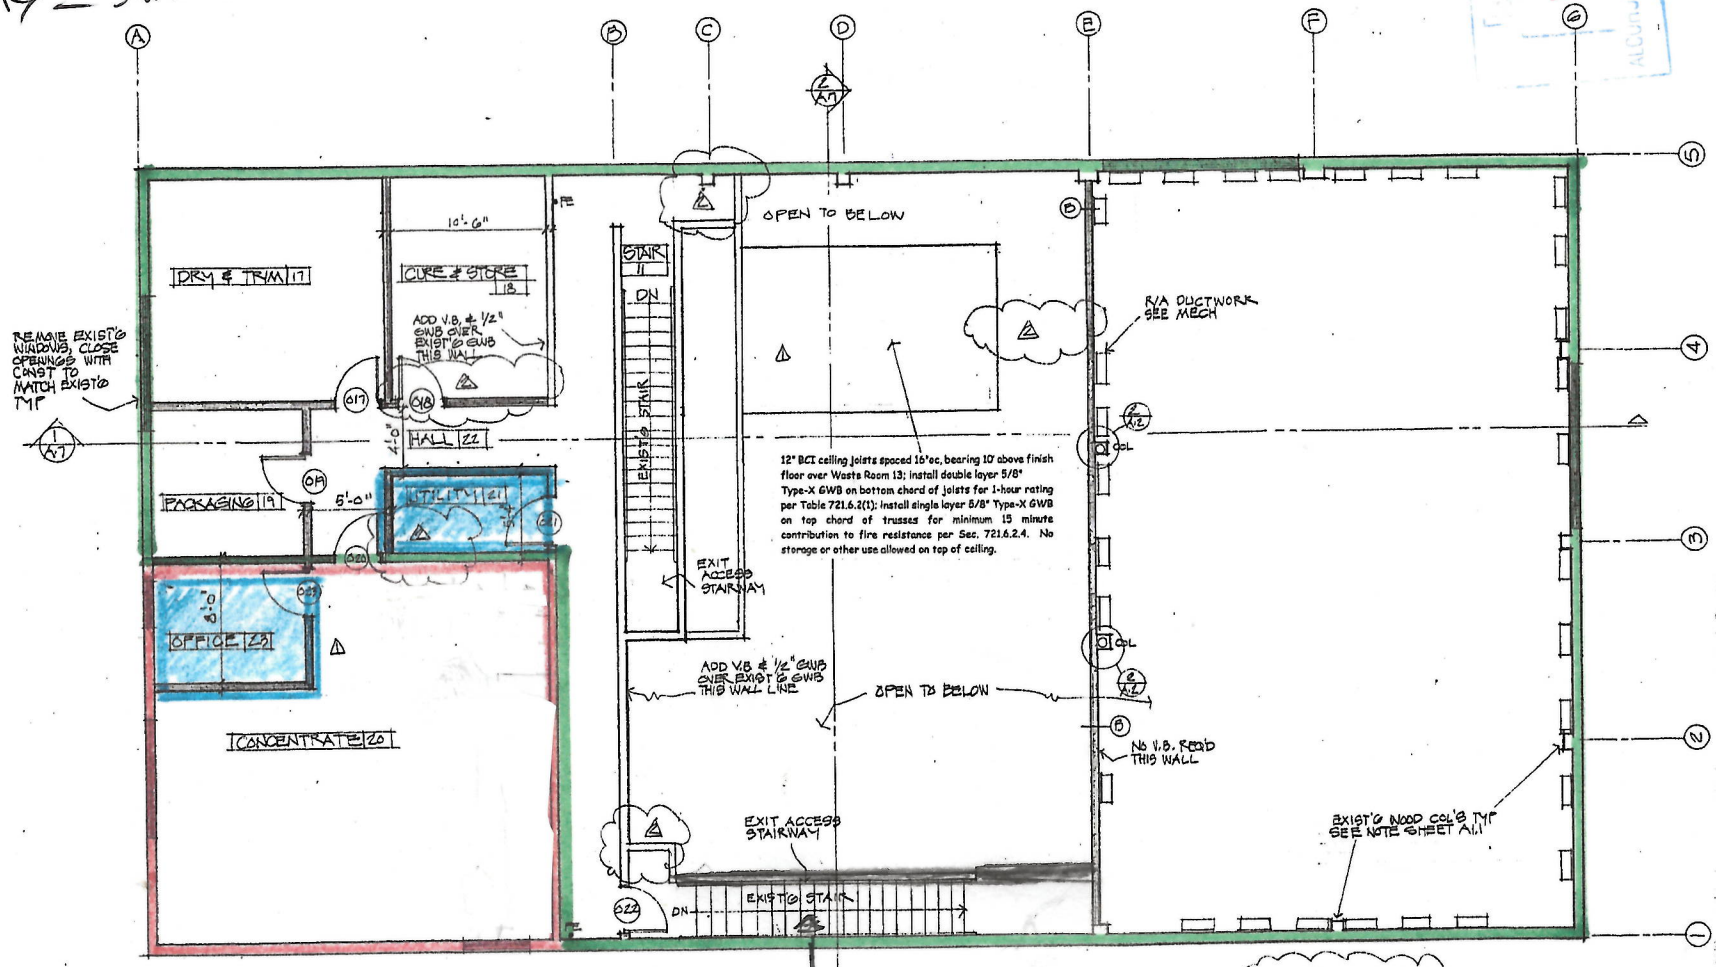

Not open to below.

"SECOND FLOOR PLAN"

1715 SF

1/4" = 1'-0"

Green = Cultivation | Restricted Access Area and Licensed premesis.

Red = Proposed Concentrates | Restricted Access

Blue = Licensed premesis | Unrestricted, Non Marijuana Storage

AMG Grow Site Building Alterations

838 Bonanza Avenue, Anchorage

Gordon Thompson Architect

711 M STREET, SUITE 101 ANCHORAGE, ALASKA 99501 (907) 279-2554

DRAWN GORDO

CHECKED G.T.

DATE 6.25.18

JOB NO. 0127

SHEET NO. A-4 OF: A-7

"GALLO"

RECEIVED DEC 19 2018 ALCOHOL & MARIJUANA CONTROL OFFICE STATE OF ALASKA

Municipality of Anchorage

Community Development Department
Development Services Division

P.O. Box 196650 - Anchorage, Alaska 99519-6650 - 4700 Elmore Road
Phone: (907) 343-8211 Fax (907) 343-8214 http://www.muni.org

CB

THIS PERMIT MUST BE POSTED IN A CONSPICUOUS PLACE AT THE ADDRESS OF WORK UNTIL WORK IS COMPLETED AND APPROVED

COMMBLDG BLDGCOMBO COMMERCIAL BUILDING PERMIT

PERMIT NO. C17-2155

Partial Permit Issuance

04/25/2018 Partial

PARTIAL INTERIOR DEMO

Issue Date: No Full Permit Issued

Expiration Date: 12/1/2018 12:00 AM

PM: pwrwp

Address of Project: 838 BONANZA AVE	**Parcel:** 01202109000
Legal: WESTGATE PARK BLK 7 LT 6 G:2029	**Subdivison:** WESTGATE PARK

Description of Work:

Change of use - From B to F-1 cannabis grow/retail facility - adding 3213 Sq Ft mezzanine - BWP

Permittee: DIAMOND CONSTRUCTION*	**Address:** PO BOX 111846 , ANCHORAGE AK	
Permit Type: BLDGCOMBO None	**Existing Use:** B	**Proposed Use:** F-1
Owner: GALLO ABRAHAM	**Address:** PO BOX 111846, ANCHORAGE AK 995111846	

All work in strict conformance with plan check requirements as per job prints. Field inspection required.

Inspection required of foundation excavation prior to placing any classified fill.

Contact the utility for approval of service equipment and location prior to installation. Service changes must be scheduled in advance with the utility company and the Building Safety Inspection section.

I HAVE READ THE ABOVE APPLICATION AND KNOW THE CONTENTS THEREOF: THE SAME IS TRUE AND CORRECT. I FURTHER AGREE THE ABOVE WORK WILL BE DONE IN ACCORDANCE WITH ALL STATE AND MUNICIPAL LAWS AND ORDINANCES.

PERMIT EXPIRES IN 360 DAYS IF WORK IS NOT COMMENCED AND NO INSPECTIONS PERFORMED.

Signature of Permittee or Agent: _____

Printed Carlos Gonzalez

RECEIVED
DEC 19 2019
ALCOHOL MARIJUANA CONTROL OFFICE
STATE OF ALASKA